

CODED

MISSISSIPPI  
BOARD OF WATER COMMISSIONERS  
416 North State Street  
Jackson, Mississippi 39201

WATER WELL DRILLERS LOG

Wayne  
U 31  
8-69

Rec. 1969 Peoples Drilling Co Wayne  
date well completed firm name county well located

LANDOWNER: James Jordan

description of formations encountered from to  
yellow sandy clay 0 27

RT 10  
Bristanna Miss.  
(mailing address)

white clay 24 63

WELL LOCATION:  
sec. 5 T 1 (N) R 5 S (W)  
6 miles N of Bristanna  
(distance) (direction) (nearest town)

SANDY clay & sand streak 63 90

white sand 90 111

WELL PURPOSE: Home  
(home, irrigation, municipal, industrial)

- WELL COMPLETION DATA:
- (1) diameter (inches) 2
  - (2) total depth (feet) 111
  - (3) static water level (feet) 67 (below top of ground)
  - (4) casing Galv. 2" (material) 105' (depth)  
2" (size) if telescope see back.
  - (5) screen 6' 2" (length) 105' (depth to top)  
2" (size) BRASS (material)
  - (6) pump 1 (HP) 8 (yield gpm)  
elect (type power)
  - (7) electric log No (yes or no)

(organization running log)

(8) how well bottom plugged Back WASH VALUE


DRILLERS REMARKS:

OCT 15 1969

MISS. BD. OF  
WATER COMM

If well telescopes please  
sketch and show depths.

GROUND LEVEL

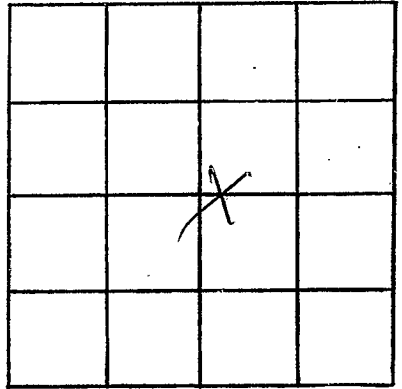

SECTION 6

Please indicate well location X.

ADDITIONAL INFORMATION

If more than one screen,  
show locations of each on sketch.