

CODED

MISSISSIPPI
BOARD OF WATER COMMISSIONERS
416 North State Street
Jackson, Mississippi 39201

WATER WELL DRILLERS LOG

Wayne
U 32
8-69

date well completed 1969 Reeples Drilling Co firm name Wayne county well located

LANDOWNER:	description of formations encountered	from	to
Andrus William	Yellow sandy clay	0	17
Buckatuna, Miss. (mailing address)	White sandy clay & small sand streak	17	63
WELL LOCATION: sec. 17 T. 30(N) S. R. 5 E. (W)	White clay	63	90
4 miles NE of Buckatuna (distance) (direction) (nearest town)	White sand	90	132

WELL PURPOSE: Home
(home, irrigation, municipal, industrial)

WELL COMPLETION DATA:

- (1) diameter (inches) 2
- (2) total depth (feet) 132
- (3) static water level (feet) 71 below top of ground.
- (4) casing Galv. 126' (material) (depth)
2" (size) if telescope see back.
- (5) screen 6' 126' (length) (depth to top)
2" BRASS (size) (material)
- (6) pump 1/2 8 (HP) (yield gpm)
elect (type power)
- (7) electric log No (yes or no)

(organization running log)

(8) how well bottom plugged Wash & pack Back


DRILLERS REMARKS:

OCT 15 1969

MISS. BD. OF
WATER COMMISSIONERS

If well telescopes please sketch and show depths.

GROUND LEVEL

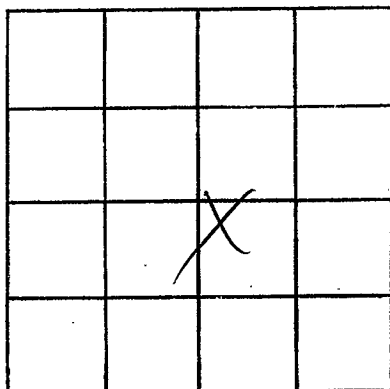

SECTION 27

Please indicate well location X.

ADDITIONAL INFORMATION

If more than one screen,
show locations of each on sketch.