

**MISSISSIPPI
BOARD OF WATER COMMISSIONERS**
416 North State Street
Jackson, Mississippi 39201

CODED

WATER WELL DRILLERS LOG

Wayne
U33
9-6-69

date well completed 9-6 1969 Cain's water well service firm name Wayne county well located

LANDOWNER: Ted GARDNER

RP1 Bucatenna

Miss
(mailing address)

WELL LOCATION:

sec. 23 T. 7 (N) R. 5 (E)
S

4 1/4 miles ENE of BUCATENNA
(distance) (direction) (nearest town)

WELL PURPOSE: Home
(home, irrigation, municipal, industrial)

WELL COMPLETION DATA:

- (1) diameter (inches) 4" x 3"
- (2) total depth (feet) 104
- (3) static water level (feet) 65 ^{below} top of ground.
- (4) casing Below, 98'
(material) (depth)
(size) If telescope see back.
- (5) screen 6', 98'
(length) (depth to top)
1 1/4", Plastic
(size) (material)
- (6) pump 1, 0
(HP) (yield gpm)
elect
(type power)
- (7) electric log
(yes or no)

(organization running log)
- (8) how well bottom plugged 1 1/4" Bar.

description of formations encountered

from

to

TOP soil	0	1
Red SANDY CLAY	1	5
PINK CLAY	5	7
GRAY & PINK CLAY	7	10
COARSE yellow SAND	10	12
Med white TOP PINK SAND	12	18
White CLAY	18	25
White & Yellow CLAY	25	32
Fine white SAND	32	36
Med yellowish SAND	36	42
COARSE white SAND	42	44
COARSE yellowish SAND	44	48
COARSE Redish SAND	48	52
COARSE yellowish SAND	52	64
yellowish & white CLAY	64	76
Yellowish & white CLAY w/ Brown Rocks	76	82
COARSE white SAND	82	93
1/4" Brown Rock w/ Coarse white sand	93	104


DRILLERS REMARKS: Set screen w/ 2" x 1 1/4" packer

OCT 20 1969

MISS. DIV. OF
WATER CONTROL

If well telescopes please sketch and show depths.

GROUND LEVEL

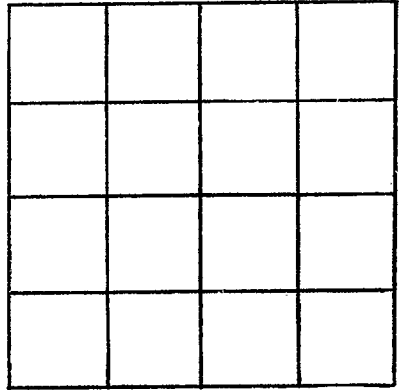

SECTION 23

Please indicate well location X.

ADDITIONAL INFORMATION

If more than one screen, show locations of each on sketch.