

**MISSISSIPPI
BOARD OF WATER COMMISSIONERS**
416 North State Street
Jackson, Mississippi 39201

CODED

WATER WELL DRILLERS LOG

Wayne
W 34
10-12-69

10/12/69 date well completed 1969 Carr's water well ser. firm name Wayne county well located

LANDOWNER: W. J. Carr
Buckatunna,
Miss
(mailing address)

WELL LOCATION:
sec 31 T 7 (N) R 5 E
3/4 miles SSE of Buckatunna
(distance) (direction) (nearest town)

WELL PURPOSE:
(home, irrigation, municipal, industrial)

WELL COMPLETION DATA:

- (1) diameter (inches) 4" x 2"
- (2) total depth (feet) 395'
- (3) static water level (feet) 1' below above
top of ground.
- (4) casing Galv., 358'
(material) (depth)
 If telescope see back.
(size)
- (5) screen None,
(length) (depth to top)
 (size) (material)
- (6) pump 8
(HP) (yield gpm)
 (type power)
- (7) electric log NO
(yes or no)
 (organization running log)
- (8) how well bottom plugged SHALE
CATCHER AT 315' + 337'

description of formations encountered	from	to
Top Soil	0	5
Coarse white sand w/ gravel	5	25
Fine white tight sand	25	28
Coarse white tight sd.	28	30
grayish sd.	30	32
Br. Rock & pea gravel	32	33
Coarse sd. w/ red + white	33	35
light gravel w/ white th.	35	37
light gravel	37	115
Coarse "	115	126
" " w/ clay balls	126	136
Bluish clay	136	146
Coarse gravel	146	156
Coarse grayish sd.	156	166
med to coarse grayish sd.	166	180
Coarse white sd.	180	230
Soft Bluish Clay	230	236
Coarse grayish sd.	236	257
Soft lime + sd.	257	262
Coarse grayish sd.	262	274
dk. Blue shale	274	315
Hd. lime R.Rock	315	320
Soft " Balls	320	325
Hd. lime Rock.	325	328
Blue shale	328	337
Hd. lime Rock.	337	349
Soft lime + med hwrk	349	375
Coarse grayish sd. + lime	375	395


OCT 20 1969

MISS. BD. OF
WATER COMMISSIONERS

DRILLERS REMARKS: ENC. H SHALE
caught on top of
lime rock

If well telescopes please sketch and show depths.

GROUND LEVEL

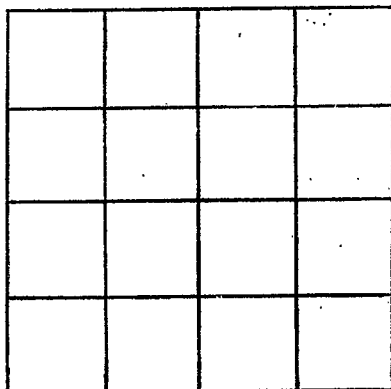

SECTION 31

Please indicate well location X.

ADDITIONAL INFORMATION

If more than one screen, show locations of each on sketch.