

Wayne  
 U36  
 1-16-70  
 1/16

MISSISSIPPI  
 BOARD OF WATER COMMISSIONERS  
 416 North State Street  
 Jackson, Mississippi 39201

CODED  
 CODED

WATER WELL DRILLERS LOG

1970 Laton well co Wayne  
 date well completed firm name county well located

LANDOWNER:  
 Russel Dearmond  
 Bucaturna miss  
 (mailing address)

description of formations encountered	from	to
Sandy Clay	0	16
Sand.	16	70
	70	87

WELL LOCATION:  
 sec. 15 T 7 N R 18 E  
 S W  
 5 miles East of Bucaturna  
 (distance) (direction) (nearest town)

WELL PURPOSE: Home  
 (home, irrigation, municipal, industrial)

WELL COMPLETION DATA:

- (1) diameter (inches) 2 in
- (2) total depth (feet) 87
- (3) static water level (feet) 16 below top of ground.
- (4) casing Galv. 87.  
 (material) (depth)  
 if telescope see back.  
 (size)
- (5) screen 9.84  
 (length) (depth to top)  
 2 85  
 (size) (material)
- (6) pump 1/2 6  
 (HP) (yield gpm)  
 E  
 (type power)
- (7) electric log No  
 (yes or no)  
 (organization running log)
- (8) how well bottom plugged Bk wash hole


JAN 28 1970

MISS. BD. OF  
 WATER COMM.

DRILLERS REMARKS:

If well telescopes please sketch and show depths.

GROUND LEVEL

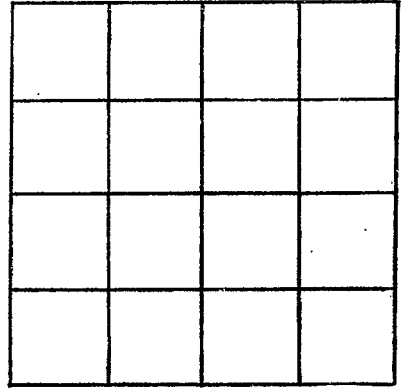

SECTION 15

Please indicate well location X.

ADDITIONAL INFORMATION

If more than one screen, show locations of each on sketch.