

Wayne
 W 38
 5-16-70

MISSISSIPPI
 BOARD OF WATER COMMISSIONERS
 416 North State Street
 Jackson, Mississippi 39201

WATER WELL DRILLERS LOG

May 16 1970 Porter Drilling & Log Wayne
 date well completed firm name county well located

LANDOWNERS: Terry Singletary
 All
 Buckatuna Miss
 (mailing address) 033

description of formations encountered	from	to
sandy clay	0	8
rock	8	40
Chalk	40	86
rock	86	88
sand	88	97
soft chalky sand	97	98
when a tiled still		
ill chalky sand		

WELL LOCATION:
 sec. 4 T. 7 N. R. 5 E.
 5 miles N of Buckatuna
 (distance) (direction) (nearest town)

WELL PURPOSE: Home
 (home, irrigation, municipal, industrial)

WELL COMPLETION DATA:
 (1) diameter (inches) 2"
 (2) total depth (feet) 98'
 (3) static water level (feet) 54' below top of ground.
 (4) casing (material) steel (depth) 93'
 (size) 2" If telescope see back.
 (5) screen (length) 5' (depth to top) 93'
 (size) 1/4" 8 slot S.S. (material)
 (6) pump 1 (HP) 11 (yield gpm)
 elec. (type power)
 (7) electric log no (yes or no)
 (organization running log)


5' 1/2" 8 slot S.S. with
 6" 1/4" size steel pipe
 with gracker
 6 3/4" 1/4" large pipe
 U U

(8) how well bottom plugged
 Blank cement
 DRILLERS REMARKS:

MAY 28 1970
 MISS. BD. OF
 WATER COMM.

If well telescopes please sketch and show depths.

GROUND LEVEL

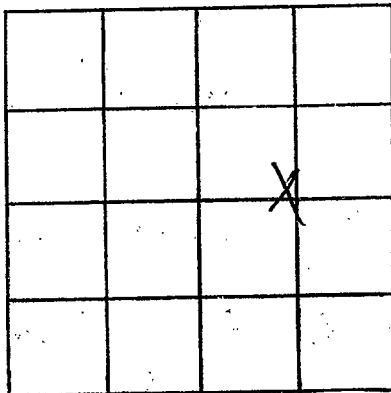

SECTION 4

Please indicate well location X.

ADDITIONAL INFORMATION

If more than one screen, show locations of each on sketch.