

Wayne

U 40

8-5-70

MISSISSIPPI  
 BOARD OF WATER COMMISSIONERS  
 416 North State Street  
 Jackson, Mississippi 39201

CODED

WATER WELL DRILLERS LOG

8-5 date well completed  
 19 70 CARRS well service WAYNE firm name county well located

LANDOWNER: W. J. CARR

BUCKATUNNA MISS

(mailing address)

description of formations encountered

from to

Topsoil	0	2
Yellow sandy clay	2	4
Pink + Gray clay	4	8
Med white sand	8	10
Coarse white SD w/ GRAY	10	26
GRAYISH CLAY	26	30
Med white sand	30	38
White + yellow clay	38	62
GRAY + PINK CLAY	62	85
PINK CLAY w/ BROWN ROCK	85	95
White clay	95	100
Pink + GRAY Rockie clay	100	112
White clay	112	125
Fine white sand	125	132
White clay	132	148
Coarse white clay	148	172
Bluish + PINK CLAY	172	177
Med white sand	177	180
Coarse white sand	180	194
DARK GRAY CLAY	194	196
Coarse white sand	196	202
Fine white sand	202	234
Bluish clay	234	238
Coarse white sand	238	243
DARK GRAY CLAY	243	251
Coarse white sand	251	254
DARK GRAY CLAY	254	258
Coarse white sand	258	269
DARK Blue shale	269	315
HARD white Lime Rock	315	318
SOFT To Med Lime Rock	318	336
HARD Lime Rock	336	352
Med Lime Rock	352	359
Med To HARD Lime Rock	359	364
BROKEN Lime Rock + Lime Rock	364	370
Med DARK SAND	370	410

WELL LOCATION:

sec. 31 T. 70 N. R. 5 E. S. 3 W.  
3/4 miles SSE of BUCKA  
 (distance) (direction) (Township)

WELL PURPOSE: Home

CHATELAIN

WELL COMPLETION DATA:

- (1) diameter (inches) 6" x 3 3/4" x 2"
- (2) total depth (feet) 410'
- (3) static water level (feet) 1' below above top of ground.
- (4) casing Galv 315'  
 (material) (depth)  
 (size) if telescope see back.
- (5) screen None  
 (length) (depth to top)  
 (size) (material)
- (6) pump 4  
 (HP) (yield gpm)  
 (type power)
- (7) electric log \_\_\_\_\_  
 (yes or no)  
 (organization running log)
- (8) how well bottom plugged 4" x 2"  
Bushman

DRILLERS REMARKS: Bushman  
is screwed in to  
ROCK APP 1 1/2"


AUG 11 1970

OVER

WATER COMM.

If well telescopes please sketch and show depths.

GROUND LEVEL

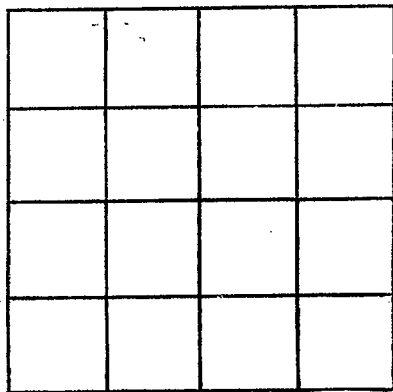

SECTION \_\_\_\_\_

Please indicate well location X.

ADDITIONAL INFORMATION

Opened hole up to 6"  
to top of rock to  
set 4"x2" Bushing in  
hole on down is 3 3/4"

If more than one screen,  
show locations of each on sketch.