

Wayne  
U41  
8-6-70

MISSISSIPPI  
BOARD OF WATER COMMISSIONERS  
416 North State Street  
Jackson, Mississippi 39201

CODED

WATER WELL DRILLERS LOG

8-6 1970 CARAS WATER WELL SERV WAYNE  
date well completed firm name county well located

LANDOWNER: HENRY BLAKLEY

BUCATUNNA MISS  
(mailing address)

description of formations encountered	from	to
TOP SOIL	0	2
GRAY + YELLOW CLAY	2	6
YELLOW CLAY	6	8
FINE WHITE SAND	8	10
MED WHITE SAND	10	20
COARSE WHITE SAND	20	28
GRAY + PINK CLAY	28	61
WHITE CLAY	61	66
FINE WHITE SAND	66	72
MED WHITE SAND	72	80
COARSE WHITE SAND	80	90

WELL LOCATION:

sec 30 T 7 N R 5 E  
S W  
1/2 miles NORTH of BUCATUNNA  
(distance) (direction) (nearest town)

WELL PURPOSE: HOME  
(home, irrigation, municipal, industrial)

WELL COMPLETION DATA:

- (1) diameter (inches) 4 1/2"
- (2) total depth (feet) 90
- (3) static water level (feet) 12 <sup>below</sup>/<sub>above</sub> top of ground.
- (4) casing GALV 84'  
(material) (depth)  
(size) if telescope see back.
- (5) screen 5' 84'  
(length) (depth to top)  
2" PLASTIC 8'  
(size) (material)
- (6) pump 1 10  
(HP) (yield gpm)  
Elec  
(type power)
- (7) electric log NO  
(yes or no)  
(organization running log)

STILL IN SAND

CODED

(8) how well bottom plugged B.W.V.  
2" w/ 1" L.H. THD


AUG 11 1970

DRILLERS REMARKS: Tested well @ 20 GAL PER MIN

MISS. BD. OF  
WATER COMM.

If well telescopes please  
sketch and show depths.

GROUND LEVEL

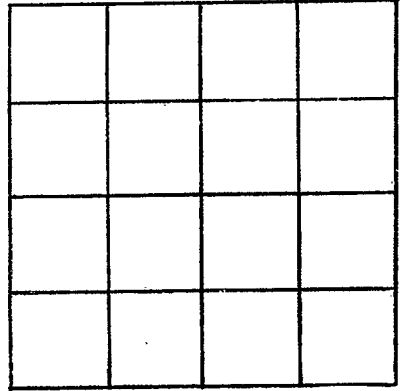

SECTION \_\_\_\_\_

Please indicate well location X.

ADDITIONAL INFORMATION

If more than one screen,  
show locations of each on sketch.