

WAYNE

U42

9-30-70

MISSISSIPPI BOARD OF WATER COMMISSIONERS
416 North State Street
Jackson, Mississippi 39201

CODED

WATER WELL DRILLERS LOG

9/30 1970
date well completed

C. P. Clark
firm name

Wayne
county well located

LANDOWNER: W.A. Wells

description of formations encountered

from

to

RT #1

Bucatema, Miss
(mailing address)

Clay
Red Sand
Clay
Sandy Clay
Sand

0 15
15 35
35 68
68 84
84 110

WELL LOCATION:

sec. 10 T. 7 N R. 14 E
6 miles East of Bucatema
(distance) (direction) (nearest town)

WELL PURPOSE: Home
(home, irrigation, municipal, industrial)

WELL COMPLETION DATA:

- (1) diameter (inches) 2
- (2) total depth (feet) 110
- (3) static water level (feet) 50 below top of ground.
- (4) casing Galv. Iron (material) (depth)

CODED

(size) if telescope see back.

- (5) screen 5 ft 105 (length) (depth to top)
1 1/4" Solid S.S. 006 (size) (material)
- (6) pump 1/22 stage 6 2/3 (HP) (yield gpm)
1100 SP (type power)
- (7) electric log No (yes or no)

(organization running log)

- (8) how well bottom plugged B.W.U.


OCT 23 1970

MISS. BD. OF WATER COMM.

DRILLERS REMARKS: 50' 8A
Gut @ 63 ft, Hales
blind @ 715 ft

If well telescopes please sketch and show depths.

GROUND LEVEL

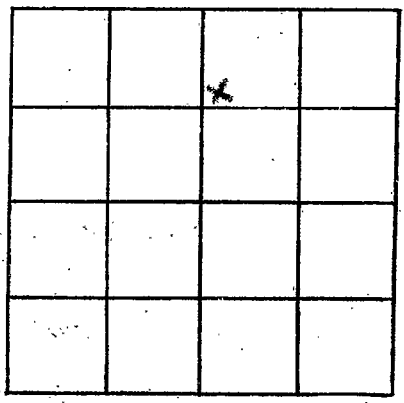

SECTION 10

Please indicate well location X.

ADDITIONAL INFORMATION

A series of horizontal lines for writing additional information.

If more than one screen, show locations of each on sketch.