

WAYNE
U 44
3-5-71

MISSISSIPPI
BOARD OF WATER COMMISSIONERS
416 North State Street
Jackson, Mississippi 39201

CODED

WATER WELL DRILLERS LOG

3-5 1971 CARAS WATER Well SERV WAYNE
date well completed firm name county well located

LANDOWNER: Johnie Waller
Rt 1 BUCATUNNA MISS
(mailing address)

WELL LOCATION:
sec. 4 T. 7 N R. 5 E
S (W)
1 1/2 miles South of Progress
(distance) (direction) (nearest town)

WELL PURPOSE: Chicken House
(home, irrigation, municipal, industrial)

WELL COMPLETION DATA:

(1) diameter (inches) 8" x 4"
(2) total depth (feet) 130
(3) static water level (feet) 56 below above top of ground.
(4) casing Galv, 126 (material) (depth)
(size) if telescope see back.
(5) screen 5', 126' (length) (depth to top)
2", PLASTIC (LOSIOT) (size) (material)
(6) pump 1 (HP) 10 (yield gpm)
ELECT (type power)
(7) electric log No (yes or no)
(organization running log)
(8) how well bottom plugged 2" BWK
W/1" Lt TAD

description of formations encountered	from	to
Top soil	0	1
Yellowish SANDY CLAY	1	3
PINK + GRAY CLAY	3	17
GRAYISH CLAY	17	25
White CLAY	25	54
Med yellowish SAND	54	64
Bluish CLAY	64	75
Pink + Bluish CLAY	75	93
Coarse white SAND	93	96
Pink + Blue CLAY	96	98
Bluish CLAY	98	115
SAND Rock 1" + med		
white SAND	115	130

CODED


MAR 10 1971

MISS. BD. OF WATER COM.

DRILLERS REMARKS: Tested well @ 14 gal PER MIN

If well telescopes please sketch and show depths.

GROUND LEVEL

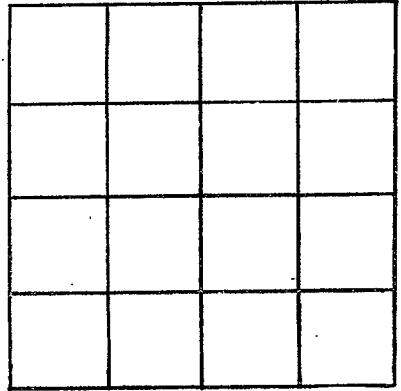

SECTION _____

Please indicate well location X.

ADDITIONAL INFORMATION

If more than one screen,
show locations of each on sketch.