

WAYNE
U 45
4-20-71

MISSISSIPPI
BOARD OF WATER COMMISSIONERS
416 North State Street
Jackson, Mississippi 39201

CODED

WATER WELL DRILLERS LOG

April 20 19 71 Booth Drilling Co Wayne
date well completed firm name county well located

LANDOWNER: Heath Gandy
Rt 1 Buckatanna Miss
(mailing address)

description of formations encountered	from	to
red clay	0	7
sand	7	20
blue chalk	20	53
sand	53	57
chalk	57	69
fine sand & chalk	69	80
fine sand	80	102
stark white stuff		
in sand		

WELL LOCATION:
sec. 19 T. 20 N. R. 5 E. W
S (distance) miles (direction) of (nearest town)

WELL PURPOSE: home
(home, irrigation, municipal, industrial)

WELL COMPLETION DATA:
(1) diameter (inches) 2
(2) total depth (feet) 102
(3) static water level (feet) 21 below above top of ground.
(4) casing steel 98'
(material) (depth)
2" If telescope see back.
(size)
(5) screen 3' 99
(length) (depth to top)
1 1/4" bslot SS
(size) (material)
(6) pump 3/4 15
(HP) (yield gpm)
elec
(type power)
(7) electric log no
(yes or no)
(organization running log)
(8) how well bottom plugged flush bottom

3' 1 1/4" bslot SS with
2 1/2' 1 1/4" drop joint
in with packer
26' 1 1/4" drop pipe

CODED


MAY 6 - 1971

DRILLERS REMARKS:

MISS. DD, OF
MAY 6
STATE QUIN.

If well telescopes please sketch and show depths.

GROUND LEVEL

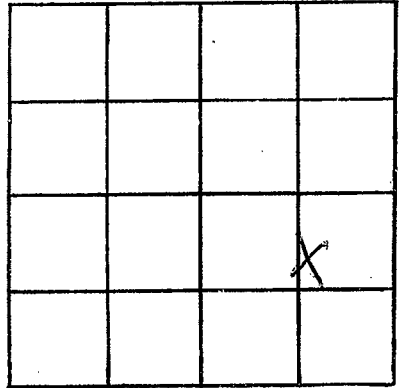

SECTION 19

Please indicate well location X.

ADDITIONAL INFORMATION

If more than one screen,
show locations of each on sketch.