

WAYNE  
 U 48  
 9-18-71

MISSISSIPPI  
 BOARD OF WATER COMMISSIONERS  
 416 North State Street  
 Jackson, Mississippi 39201

WATER WELL DRILLERS LOG

**CODED**

9-18 19 71 CARRS well service WAYNE  
 date well completed firm name county well located

LANDOWNER: LUTHER TAYLOR  
Rt 1 BYCATUNNA  
MISS  
 (mailing address)

description of formations encountered	from	to
Top Soil	0	2
Med Red SAND	2	20
Fine yellowish SAND	20	30
White CLAY	30	34
Pea GRAVEL	34	40
Med yellowish SAND	40	55
Coarse white SAND	55	60

WELL LOCATION:  
 sec 33 T. 7N R. 5E  
S W  
1 1/4 miles D North of PROGRESS  
 (distance) (direction) (nearest town)

WELL PURPOSE: HOME  
 (home, irrigation, municipal, industrial)

- WELL COMPLETION DATA:
- (1) diameter (inches) 2" X 4"
  - (2) total depth (feet) 60
  - (3) static water level (feet) 36' <sup>below</sup> <sub>above</sub> top of ground.
  - (4) casing Galv, 56'  
 (material) (depth)  
 (size) If telescope see back.
  - (5) screen 4', 56'  
 (length) (depth to top)  
2", PLASTIC  
 (size) (material)
  - (6) pump 1 6  
 (HP) (yield gpm)  
Elect  
 (type power)
  - (7) electric log No  
 (yes or no)  
 (organization running log)
  - (8) how well bottom plugged 2" Bunk


**CODED**

DRILLERS REMARKS:

OCT 7 - 1971

If well telescopes please sketch and show depths.

GROUND LEVEL

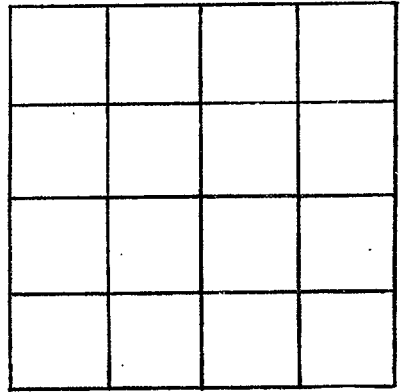

SECTION \_\_\_\_\_

Please indicate well location X.

ADDITIONAL INFORMATION

If more than one screen,  
show locations of each on sketch.