

WAYNE
U 51
11-17-71

MISSISSIPPI
BOARD OF WATER COMMISSIONERS
416 North State Street
Jackson, Mississippi 39201
WATER WELL DRILLERS LOG

CODED

16-17 1971 CARRS WATER WELL SERV WAGNER
date well completed firm name county well located

LANDOWNER: CLIFFORD SMITH	description of formations encountered	from	to
RT 1 BUCATUNNA	Top Soil	0	1
MISS (mailing address)	yellow SAND	1	3
	Coarse yellow SAND	3	5
	yellow CLAY	5	12
	Med yellowish SAND	12	30
	White & pink CLAY	30	1

WELL LOCATION:
sec. 15 T. 7 N. R. 5 E. S. W.
4 miles ENE of BUC (distance) (direction) (nearest town)

WELL PURPOSE: HOME (home, irrigation, municipal, industrial)

- WELL COMPLETION DATA:
- (1) diameter (inches) 4 1/2"
 - (2) total depth (feet) 31
 - (3) static water level (feet) 16 below top of ground.
 - (4) casing PVC, 26' (material) (depth)
 - (size) If telescope see back.
 - (5) screen 4' 26' (length) (depth to top)
 - 2" PVC (size) (material)
 - (6) pump 10510T GATOR 5 (HP) (yield gpm)
 - ELECT (type power)
 - (7) electric log NO (yes or no)
 - (organization running log)
 - (8) how well bottom plugged BUILT IN BACK WASH VALVE


CODED

NOV 22 1971
MISS. BU. OF WATER RESOURCES
MISS. DEPT. OF WATER CONTROL

DRILLERS REMARKS: Tested well @ 17 GAL PER MIN

If well telescopes please sketch and show depths.

GROUND LEVEL

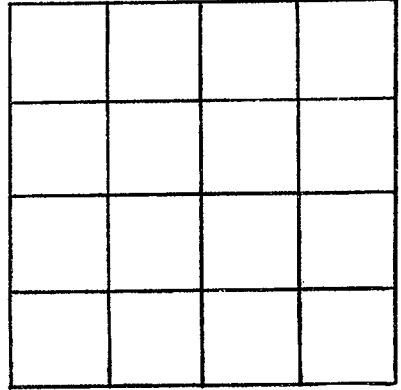

SECTION _____

Please indicate well location X.

ADDITIONAL INFORMATION

If more than one screen,
show locations of each on sketch.