

Wayne  
 U52  
 11-18-71

MISSISSIPPI  
 BOARD OF WATER COMMISSIONERS  
 416 North State Street  
 Jackson, Mississippi 39201

**CODED**

WATER WELL DRILLERS LOG

11-18 1971 CARRS WATER WELL SERV WAYNE  
 date well completed firm name county well located

LANDOWNER	description of formations encountered	from	to
OSCAR BRADLEY	Topsoil	0	2
<del>IR: RT</del>	Yellow Clay	2	9
RT1 BUCATUNNA MISS (mailing address)	Yellow Sand	9	12
	Coarse white sand	12	30

WELL LOCATION:  
 sec 30 T 10 N R 5 W  
 S W  
 IN BUCATUNNA  
 (distance) miles (direction) of (nearest town)

WELL PURPOSE: CREE  
 (home, irrigation, municipal, industrial)

- WELL COMPLETION DATA:
- diameter (inches) 4 1/2"
  - total depth (feet) 30
  - static water level (feet) 12 <sup>below</sup> <sub>above</sub> top of ground.
  - casing PVC 34  
 (material) (depth)  
 (size) if telescope see back.
  - screen 5' 34'  
 (length) (depth to top)  
 2" PVC (10 slot)  
 (size) (material)
  - pump 1  
 (HP) (yield gpm)  
 Elect  
 (type power)
  - electric log NO  
 (yes or no)  
 (organization running log)
  - how well bottom plugged 2" BWV

**CODED**


NOV 22 1971

DRILLERS REMARKS: Tested @  
 30 G.P.M.

MISC. RD. OF  
 WATER COMM.

If well telescopes please sketch and show depths.

GROUND LEVEL

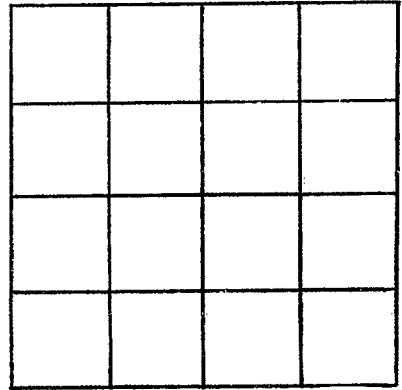

SECTION \_\_\_\_\_

Please indicate well location X.

ADDITIONAL INFORMATION

If more than one screen, show locations of each on sketch.