

Wayne
 U.S.S.
 11-30-71

MISSISSIPPI
 BOARD OF WATER COMMISSIONERS 8
 416 North State Street
 Jackson, Mississippi 39201

CODED
 76-57
 1971
 COMP

WATER WELL DRILLERS LOG

Nov 30 19 71 River Water Well Wayne
 date well completed firm name county well located

LANDOWNER:
Floyd Mc Clellin
RT 3 Waynesboro, Miss
 (mailing address)

description of formations encountered	from	to
Top soil	0	2
Red clay	2	22
fine sand	22	32
White chalk	32	60
White water sand	60	80
Total	80	

WELL LOCATION:
 sec. 7 T. 7 N. R. 5 E.
4 miles north of Buckatunna
 (distance) (direction) (nearest town)

WELL PURPOSE: Home
 (home, irrigation, municipal, industrial)

WELL COMPLETION DATA:

(1) diameter (inches) 4"

(2) total depth (feet) 80'

(3) static water level (feet) 60' below above top of ground.

(4) casing 2" 77'
 (material) (depth)

_____ if telescope see back.
 (size)

(5) screen 3' 80'
 (length) (depth to top)
1 1/4, 60g Brass lined
 (size) (material)

(6) pump 3/4 6
 (HP) (yield gpm)
Electric
 (type power)

(7) electric log NO
 (yes or no)

_____ (organization running log)


(8) how well bottom plugged Drive
Point

CODED

DRILLERS REMARKS: Good

If well telescopes please sketch and show depths.

GROUND LEVEL

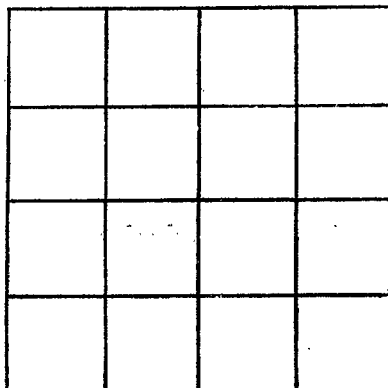

SECTION _____

Please indicate well location X.

ADDITIONAL INFORMATION

If more than one screen,
show locations of each on sketch.