

WAYNE
U 56
5-18-72

MISSISSIPPI
BOARD OF WATER COMMISSIONERS
416 North State Street
Jackson, Mississippi 39201

CODED

WATER WELL DRILLERS LOG

5/18 1972 CARRS well service WAYNE
date well completed firm name county well located

LANDOWNER: F.C. Rigney
RT1 BUCATUNNA MISS
(mailing address)
WELL LOCATION:
sec. 23 T. 7 N R. 5 E
S W
2 miles NNE of BUCATUNNA
(distance) (direction) (nearest town)

description of formations encountered	from	to
yellow SAND	0	10
Med white SAND	10	21
COARSE white SAND	21	28
Fine white SAND w/ clay	28	31
white CLAY	31	37
COARSE white SAND	37	41
HIT white CLAY	41	

WELL PURPOSE: Home
(home, irrigation, municipal, industrial)

WELL COMPLETION DATA:
(1) diameter (inches) 4 1/4 x 2"
(2) total depth (feet) 40'
(3) static water level (feet) 18' below above top of ground.
(4) casing PVC, 36' (material) (depth)
(size) If telescope see back.
(5) screen 5' 36' (length) (depth to top)
2" PVC (size) (material)
(6) pump 1/3 (HP) 3 (yield gpm)
Elect (type power)
(7) electric log No (yes or no)
(organization running log)
(8) how well bottom plugged 2" MCME B.W.V.

CODED


JUN - 6 1972

DRILLERS REMARKS: Tested well @ 7 1/2 gal per MIN

MISS. BD. OF
WATER COM. S.

If well telescopes please sketch and show depths.

GROUND LEVEL

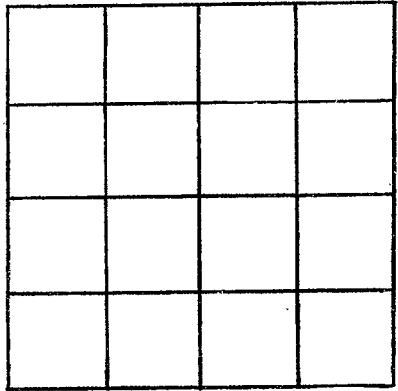

SECTION _____

Please indicate well location X.

ADDITIONAL INFORMATION

If more than one screen, show locations of each on sketch.