

Wayne
 U 57
 6-30-72

MISSISSIPPI
 BOARD OF WATER COMMISSIONERS
 416 North State Street
 Jackson, Mississippi 39201


WATER WELL DRILLERS LOG

June 30 1972 Risen Water Well Drll. Wayne
 date well completed firm name county well located

LANDOWNER:	description of formations encountered	from	to
W.B. Willford	TOP SOIL	0	2
RT 1 BUCKATUNNA, MISS (mailing address)	Red CLAY	2	13
	FINE SAND	13	18
WELL LOCATION:	TOTAL	18'	
sec. 13 T 7 N R 5 E 2 1/2 miles NORTH of BUCKATUNNA (distance) (direction) (nearest town)			
WELL PURPOSE: Home (home, irrigation, municipal, industrial)			
WELL COMPLETION DATA:			
(1) diameter (inches) 4"			
(2) total depth (feet) 18'			
(3) static water level (feet) 13' below top of ground.			
(4) casing 1 1/2" 15' (material) (depth)			
_____ if telescope see back. (size)			
(5) screen 3' 18' (length) (depth to top)			
1 1/2" BRASS LINED (size) (material)			
(6) pump HAND PUMP 2 (HP) (yield gpm)			
NONE (type power)			
(7) electric log NO (yes or no)			
_____ (organization running log)			
(8) how well bottom plugged DRIVE POINT	JUN 10 1972		
DRILLERS REMARKS: POOR			

If well telescopes please sketch and show depths.

GROUND LEVEL

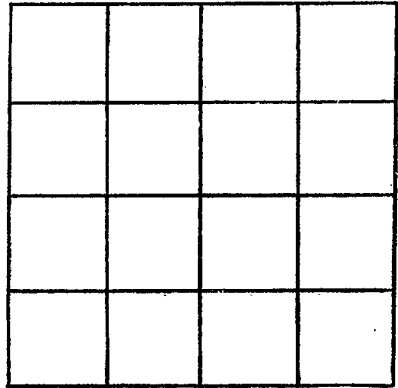

SECTION _____

Please indicate well location X.

ADDITIONAL INFORMATION

If more than one screen,
show locations of each on sketch.