

WAYNE
U 62
9-27-72

MISSISSIPPI
BOARD OF WATER COMMISSIONERS
416 North State Street
Jackson, Mississippi 39201

WATER WELL DRILLERS LOG

CODED

Sept 27 1972 River Water Well Serv Wayne
date well completed firm name county well located

LANDOWNER:
Ernest Hayes
RT 1 Ruckath, Miss
(mailing address)

description of formations encountered	from	to
Top soil	0	1
Red clay	1	4
Red & White Chalk	4	13
White coarse sand	13	18
Gravel & sand	18	21
Total	21	Feet

WELL LOCATION:
sec. 31 T 7 N R 5 E S
3 1/2 miles South of Ruckath, Miss
(distance) (direction) (nearest town)

WELL PURPOSE: Home
(home, irrigation, municipal, industrial)

WELL COMPLETION DATA:

(1) diameter (inches) 3"

(2) total depth (feet) 21'

(3) static water level (feet) 13' below top of ground.

(4) casing 2" 18'
(material) (depth)
(size) if telescope see back.

(5) screen 3' 21'
(length) (depth to top)
1 1/2" Brass coated
(size) (material)

(6) pump 1 8
(HP) (yield gpm)
Electric
(type power)

(7) electric log No
(yes or no)
(organization running log)

CODED

OC 1 - 5 1579


(8) how well bottom plugged Drive-Point

DRILLERS REMARKS: Good

RD. OF
ENGINEER

If well telescopes please sketch and show depths.

GROUND LEVEL

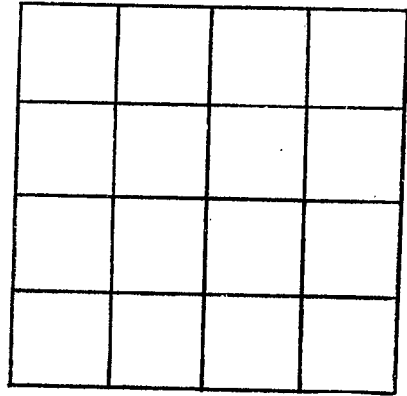

SECTION _____

Please indicate well location X.

ADDITIONAL INFORMATION

Lined area for additional information.

If more than one screen, show locations of each on sketch.