

Wayne
 U64
 10-28-72

MISSISSIPPI
 BOARD OF WATER COMMISSIONERS
 416 North State Street
 Jackson, Mississippi 39201

CODED

WATER WELL DRILLERS LOG

EX 28 1972 River Water Well Ser Wayne
 date well completed firm name county well located

LANDOWNER: Rudy Lee
 RT4, Waynesboro, Miss.
 (mailing address)

description of formations encountered	from	to
TOP SOIL	0	2
RED SAND	2	28
COARSE GRAVEL SAND	28	35
WHITE COARSE SAND	35	55
RED SAND & GRAVEL	55	70
RED & WHITE SAND	70	80
WHITE CHALK	80	83
WHITE SAND	83	90
BIG GRAVEL & SAND	90	103
TOTAL	103	

WELL LOCATION:
 sec. 18 T 7 N R 5 E
 S W
 3 miles north of Buckatunna
 (distance) (direction) (nearest town)

WELL PURPOSE: Home
 (home, irrigation, municipal, industrial)

- WELL COMPLETION DATA:
- (1) diameter (inches) 4"
 - (2) total depth (feet) 103'
 - (3) static water level (feet) 53' below top of ground.
 - (4) casing 2" Galv, 100'
 (material) (depth)
 (size) if telescope see back.
 - (5) screen 3' 103'
 (length) (depth to top)
 1 1/2" BRASS LINED
 (size) (material)
 - (6) pump 1 1/2
 (HP) (yield gpm)
 Electric
 (type power)
 - (7) electric log NO
 (yes or no)
 (organization running log)
 - (8) how well bottom plugged Drive Point

CODED

NOV 14 1972


MISS. Bd. OF
 WATER COMMISSIONERS

DRILLERS REMARKS: Good

If well telescopes please
sketch and show depths.

2100

GROUND LEVEL

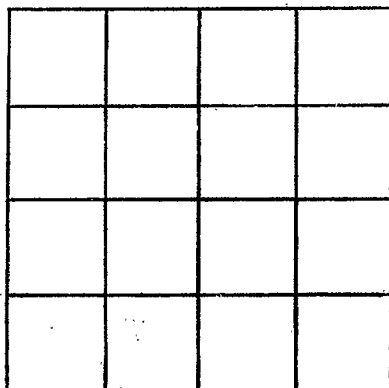

SECTION _____

Please indicate well location X.

ADDITIONAL INFORMATION

A series of horizontal lines for recording additional information.

2100

If more than one screen,
show locations of each on sketch.