

WAYNE

U 65

2-7-73

MISSISSIPPI BOARD OF WATER COMMISSIONERS 416 North State Street Jackson, Mississippi 39201

WATER WELL DRILLERS LOG

Feb. 7 1973 Porter Drilling & Log Wayne date well completed firm name county well located

LANDOWNER: Robert Ballard

description of formations encountered	from	to
	clay & chalk	0
sh. s.	8	20
course sand pea gravel	20	26
course sand	26	47
chalk & sand	47	49

Rt 4 Wayneboro (mailing address)

WELL LOCATION:

sec. 11 T. 7 N R. 5 E 6 miles S.E. of Wayneboro (distance) (direction) (nearest town)

WELL PURPOSE: Irrigation (home, irrigation, municipal, industrial)

Screen removed on casing

WELL COMPLETION DATA:

- (1) diameter (inches) 2"
- (2) total depth (feet) 42'
- (3) static water level (feet) 13' below top of ground
- (4) casing steel 42' (material) (depth) 2' if telescope see back (size)
- (5) screen 5' 42 (length) (depth to top) 1 1/4" hole 5.5 (size) (material)
- (6) pump 3/4 12 (HP) (yield gpm) elec (type power)
- (7) electric log no (yes or no)

37' 1" galvanized pipe

CODED

(organization running log)


(8) hole well bottom plugged flush cement

FEB 9 1973

DRILLERS REMARKS:

If well telescopes please
sketch and show depths.

GROUND LEVEL

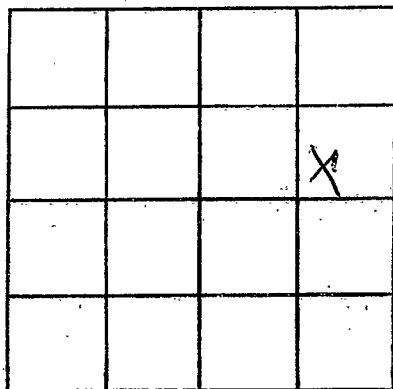

SECTION 11

Please indicate well location X.

ADDITIONAL INFORMATION

If more than one screen,
show locations of each on sketch.