

MISSISSIPPI
BOARD OF WATER COMMISSIONERS
416 North State Street
Jackson, Mississippi 39201

CODED

WAYNE

U 67

4-18-73

WATER WELL DRILLERS LOG

April 18 1973 Booth Drilling Corp Wayne
date well completed firm name county well located

LANDOWNER: Hallman Ben

description of formations encountered

from

to

J. Leming
Box 1 Buckatanna
(mailing address)

meat clay	0	20
meat chalk	20	70
white chalk	70	130
meat coarse white sand	130	135
stagnant white water in sand		

WELL LOCATION:

sec. 5 T. 7 N. R. 5 E. W. W
4 1/2 miles N of Buckatanna
(distance) (direction) (nearest town)

WELL PURPOSE: Home
(home, irrigation, municipal, industrial)

WELL COMPLETION DATA:

- (1) diameter (inches) 2"
- (2) total depth (feet) 135
- (3) static water level (feet) 99 (below above top of ground)
- (4) casing steel, 131' (material) (depth)
2' (size) if telescope see back.
- (5) screen 3', 132' (length) (depth to top)
1 1/4", 6 slot SS. (size) (material)
- (6) pump 1 1/2, 7 1/2 (HP) (yield gpm)
elec. (type power)
- (7) electric log no (yes or no)

112' 1 1/4" dia pipe
2' 1 1/2" 6 slot SS.
with 2' 1 1/4" dia pipe
fracture with grackles

CODED


(organization running log)

(8) how well bottom plugged
flush ground

DRILLERS REMARKS:

If well telescopes please sketch and show depths.

GROUND LEVEL

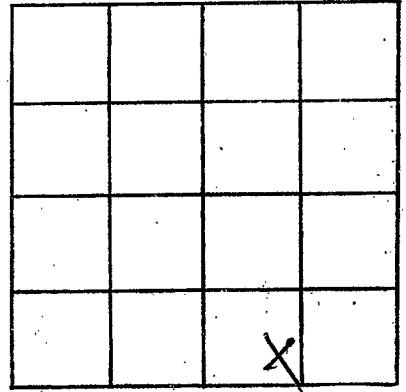

SECTION 5

Please indicate well location X.

ADDITIONAL INFORMATION

If more than one screen,
show locations of each on sketch.