

WAYNE
U 68
5-20-73

MISSISSIPPI
BOARD OF WATER COMMISSIONERS
416 North State Street
Jackson, Mississippi 39201

CODED

WATER WELL DRILLERS LOG

5/30 1973 Camwell Bros Wayne
date well completed firm name county well located

LANDOWNER: Jackie
Powe
RT 1 Bucateen
(mailing address)

WELL LOCATION:
sec 14 T 7N R 5E
S W
4 1/2 miles ENE of BUC
(distance) (direction) (nearest town)

WELL PURPOSE: Domestic
(home, irrigation, municipal, industrial)

WELL COMPLETION DATA:
(1) diameter (inches) 4 1/2 x 2
(2) total depth (feet) 65
(3) static water level (feet) 54 ^{below} above top of ground.
(4) casing Galv 63
(material) (depth)
(size) if telescope see back.
(5) screen 3" 63'
(length) (depth to top)
1/4" 3 Steel
(size) (material)
(6) pump 1 7
(HP) (yield gpm)
Elect
(type power)
(7) electric log NO
(yes or no)
(organization running log)
(8) how well bottom plugged DRIVE
Paint

description of formations encountered	from	to
top soil	0	2
yellow sandy clay	2	6
med yellowish sand	6	14
white yellow pink clay	14	25
white clay	25	27
white sand	27	29
white clay	29	32
med yellowish sand	32	42
coarse red sand	42	56
Rock @ 56' went		
Blind To 65'		

CODED


MAY 11 1973

DRILLERS REMARKS: set up
9" Packer
Tested @ 10 gpm

MISSISSIPPI
BOARD OF WATER COMMISSIONERS

If well telescopes please sketch and show depths.

GROUND LEVEL

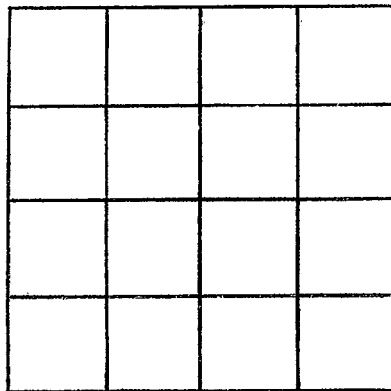

SECTION _____

Please indicate well location X.

ADDITIONAL INFORMATION

If more than one screen,
show locations of each on sketch.