

WAYNE
 1270
 8-23-73

MISSISSIPPI
 BOARD OF WATER COMMISSIONERS CODED
 416 North State Street
 Jackson, Mississippi 39201

WATER WELL DRILLERS LOG

8/23 1973 Caris water well Levee Wayne
 date well completed firm name county well located

LANDOWNER: p.p. Flanagan
Rt 1 Bucatenna Miss
 (mailing address)

WELL LOCATION:
 sec 21 T 7 N R 5 E
S W
3 miles NE of BUCATENNA
 (distance) (direction) (nearest town)

WELL PURPOSE: HOME
 (home, irrigation, municipal, industrial)

WELL COMPLETION DATA:
 (1) diameter (inches) 2"
 (2) total depth (feet) 132
 (3) static water level (feet) 64 below above top of ground.
 (4) casing PVC, 127
 (material) (depth)
 (size) if telescope see back.
 (5) screen 5', 127
 (length) (depth to top)
2, PVC 8 slot
 (size) (material)
 (6) pump 1 7
 (HP) (yield gpm)
Elect
 (type power)
 (7) electric log No
 (yes or no)
 (organization running log)
 (8) how well bottom plugged 2" Bl. W. V.


description of formations encountered	from	to
TOP SOIL	0	1
Red sandy Clay	1	15
Coarse Red sand	15	18
White CLAY	18	36
Broken pink CLAY & B. Rock	36	38
BROWN SAND	38	52
pink CLAY w/ B. Rock	52	55
white CLAY	55	57
SAND last part RAN	57	60
4" CSY + DRIFT		
white CLAY	60	63
Blue CLAY	63	78
yellow sticky CLAY	78	88
med white SAND	88	93
Bluish CLAY	93	100
med white SAND	100	104
Bluish CLAY	104	107
med white SAND	107	117
COARSE white SAND	117	132

DRILLERS REMARKS: still in sand when quit drilling

DATE 8/23/73
 MISS. BO. OF WATER COM.

If well telescopes please sketch and show depths.

GROUND LEVEL

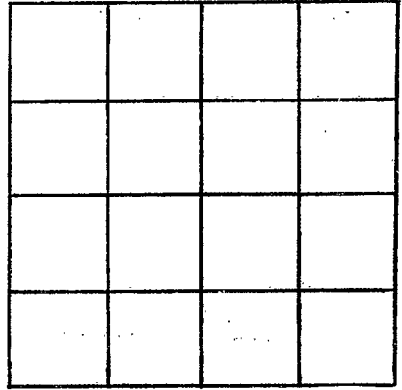

SECTION _____

Please indicate well location X.

ADDITIONAL INFORMATION

If more than one screen, show locations of each on sketch.