

**WAYNE**  
U 73  
11-10-73

MISSISSIPPI  
 BOARD OF WATER COMMISSIONERS  
 416 North State Street  
 Jackson, Mississippi 39201

**CODED**

**WATER WELL DRILLERS LOG**

11-10 1973 CARRS well serv WAYNE  
 date well completed firm name county well located

LANDOWNER: <u>WALTER SCUMBALL</u>	description of formations encountered	from	to
<u>Rt 1 BUCHANNA MISS</u> (mailing address)			
<b>WELL LOCATION:</b>	<u>TOP SOIL</u>	<u>0</u>	<u>1</u>
sec. <u>17</u> T. <u>7N</u> S. R. <u>3E</u> <u>W</u>	<u>yellow SAND</u>	<u>1</u>	<u>2</u>
<u>3</u> miles <u>NNE</u> of <u>BUC</u>	<u>yellow + white CLAY</u>	<u>2</u>	<u>14</u>
(distance) (direction) (nearest town)	<u>Pink + white CLAY</u>	<u>14</u>	<u>17</u>
<b>WELL PURPOSE:</b> <u>Home</u> (home, irrigation, municipal, industrial)	<u>white CLAY</u>	<u>17</u>	<u>23</u>
<b>WELL COMPLETION DATA:</b>	<u>Brown Rock + white CLAY</u>	<u>23</u>	<u>26</u>
(1) diameter (inches) <u>2"</u>	<u>Fine white SAND</u>	<u>26</u>	<u>32</u>
(2) total depth (feet) <u>120</u>	<u>Med Pink SAND</u>	<u>32</u>	<u>38</u>
(3) static water level (feet) <u>35</u> <u>below</u> above top of ground.	<u>COARSE Pink SAND</u>	<u>38</u>	<u>41</u>
(4) casing <u>PVC</u> <u>110</u> (material) (depth)	<u>Whit + yellow CLAY</u>	<u>41</u>	<u>61</u>
(size) If telescope see back.	<u>Fine fine white SAND</u>	<u>61</u>	<u>71</u>
(5) screen <u>10</u> <u>110'</u> (length) (depth to top)	<u>Bluish CLAY</u>	<u>71</u>	<u>82</u>
<u>2"</u> <u>PVC 8 slot</u> (size) (material)	<u>Pink + white CLAY</u>	<u>82</u>	<u>86</u>
(6) pump <u>1</u> <u>8</u> (HP) (yield gpm)	<u>white CLAY</u>	<u>86</u>	<u>95</u>
<u>Elect</u> (type power)	<u>COARSE white SAND</u>	<u>95</u>	<u>120</u>
(7) electric log <u>No</u> (yes or no)			
(organization running log)			
(8) how well bottom plugged <u>2" B.W.V.</u>			
<b>DRILLERS REMARKS:</b> <u>still in SAND when quit Drilling</u>			


**CODED**

JAN 8 1974

MISSISSIPPI BOARD OF WATER COMMISSIONERS

If well telescopes please sketch and show depths.

GROUND LEVEL

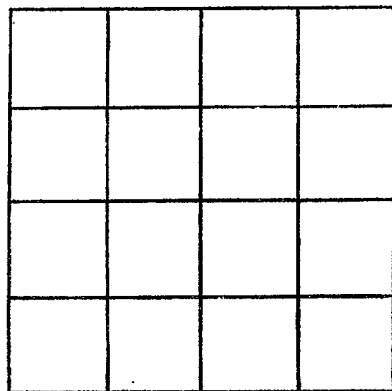

SECTION \_\_\_\_\_

Please indicate well location X.

ADDITIONAL INFORMATION

If more than one screen, show locations of each on sketch.