

WAYNE  
U 74  
3-4-74

MISSISSIPPI  
BOARD OF WATER COMMISSIONERS  
416 North State Street  
Jackson, Mississippi 39201

CODED

WATER WELL DRILLERS LOG

March 4 1974 W. D. ... Wayne  
date well completed firm name county well located

LANDOWNER: J. C. Jones

description of formations encountered	from	to
Sand	0	14
Shale	14	15
Chalk	15	65
Hard sand	65	69
Shale	69	78
Blue clay sand	78	89
Light on chalk		

211 Buchatonna, Miss  
(mailing address)

WELL LOCATION:  
sec 32 T 7 N R 5 E  
1 miles 5 of Buchatonna  
(distance) (direction) (nearest town)

WELL PURPOSE: home  
(home, irrigation, municipal, industrial)


WELL COMPLETION DATA:

- (1) diameter (inches) 2"
- (2) total depth (feet) 89'
- (3) static water level (feet) 13' below top of ground.
- (4) casing PVC 84'  
(material) (depth)  
2' if telescope see back.  
(size)
- (5) screen 5' 84'  
(length) (depth to top)  
1 1/2" hard SS  
(size) (material)
- (6) pump 3/4 8 1/2  
(HP) (yield gpm)  
elec  
(type power)
- (7) electric log no  
(yes or no)

5' 1 1/2" chd SS casing  
on end of case with  
hook which will connect  
with shell tray on top

40' 1" PVC drop pipe

CODED

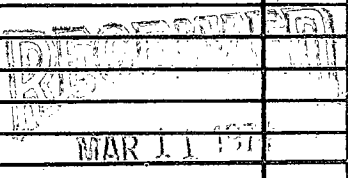


(organization running log)

(8) how well bottom plugged  
hard sand shale

DRILLERS REMARKS:

If well telescopes please  
sketch and show depths.

GROUND LEVEL

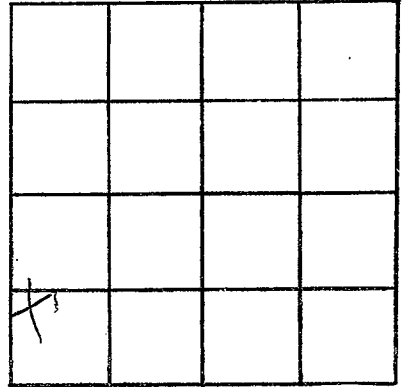

SECTION 32

Please indicate well location X.

ADDITIONAL INFORMATION

If more than one screen,  
show locations of each on sketch.