

WAYNE
 U 76
 5-9-74

MISSISSIPPI
 BOARD OF WATER COMMISSIONERS
 416 North State Street
 Jackson, Mississippi 39201

WATER WELL DRILLERS LOG

CODED

May 9 1974 date well completed
 24 Probs-Drilling Co. firm name
 Wayne county well located

LANDOWNER: <u>John Fields</u>	description of formations encountered	from	to
<u>211 Buckatanna</u> (mailing address)	<u>clay & chalk</u>	<u>0</u>	<u>18</u>
	<u>s.s.</u>	<u>18</u>	<u>27</u>
	<u>clay & chalk</u>	<u>27</u>	<u>36</u>
	<u>stop on hard chalk</u>		

WELL LOCATION:
 sec. 19 T 7 N R 5 E
 S W
1 miles N of Buckatanna
 (distance) (direction) (nearest town)

WELL PURPOSE: home
 (home, irrigation, municipal, industrial)

- WELL COMPLETION DATA:
- (1) diameter (inches) 1 1/4
 - (2) total depth (feet) 26
 - (3) static water level (feet) 9 below top of ground.
 - (4) casing steel, 21'
 (material) (depth)
1 1/4 if telescope see back.
 (size)
 - (5) screen 5, 21
 (length) (depth to top)
1 1/4, below S.S.
 (size) (material)
 - (6) pump 3/4 10
 (HP) (yield gpm)
elec
 (type power)
 - (7) electric log no
 (yes or no)

(organization running log)

(8) how well bottom plugged
plugged


DRILLERS REMARKS:

CODED

RECEIVED
 JUL 24 1974

If well telescopes please sketch and show depths.

GROUND LEVEL

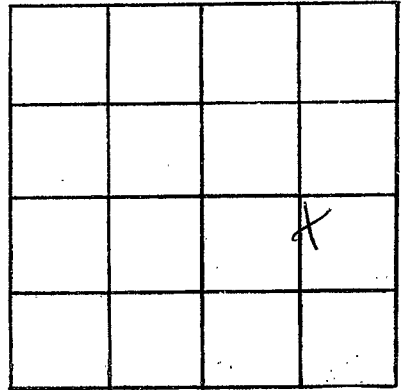

SECTION 19

Please indicate well location X.

ADDITIONAL INFORMATION

If more than one screen,
show locations of each on sketch.