

WAYNE
W 77
3-19-75

MISSISSIPPI
 BOARD OF WATER COMMISSIONERS
 416 North State Street
 Jackson, Mississippi 39201

CODED

WATER WELL DRILLERS LOG

3-19-1975 CARRS Well SERV ²⁰⁵ WAYNE
 date well completed firm name county well located


LANDOWNER:	description of fomations encountered	from	to
<u>Louis Chapel</u> <u>Chuck Ch</u>	<u>yellow & white clay</u>	<u>0</u>	<u>15</u>
<u>PT 1 BUCKTOWN MISS</u> (mailing address)	<u>pink & white clay</u>	<u>15</u>	<u>21</u>
WELL LOCATION:	<u>yellow & white clay</u>	<u>21</u>	<u>25</u>
sec. <u>4</u> T. <u>7</u> N. R. <u>5</u> E	<u>bluish clay</u>	<u>25</u>	<u>35</u>
(distance) miles <u>at</u> (direction) of <u>Progress</u> (nearest town)	<u>1/2 BR - yellow & white clay</u>	<u>35</u>	<u>37</u>
WELL PURPOSE: <u>Home</u> (home, irrigation, municipal, industrial)	<u>pink & white clay</u>	<u>37</u>	<u>39</u>
WELL COMPLETION DATA:	<u>fine sand</u>	<u>39</u>	<u>41</u>
(1) diameter (inches) <u>4" x 2"</u>	<u>pink & white clay</u>	<u>41</u>	<u>47</u>
(2) total depth (feet) <u>145</u>	<u>yellow & white clay</u>	<u>47</u>	<u>55</u>
(3) static water level (feet) <u>75</u> below top of ground.	<u>blue clay</u>	<u>55</u>	<u>70</u>
(4) casing <u>PVC, 140</u> (material) (depth)	<u>fine yellow sand</u>	<u>70</u>	<u>74</u>
(size) if telescope see back.	<u>sandy yellow clay</u>	<u>74</u>	<u>88</u>
(5) screen <u>5</u> , <u>140</u> (length) (depth to top)	<u>fine white sand</u>	<u>88</u>	<u>90</u>
<u>2" x PVC (9 slot)</u> (size) (material)	<u>blue clay</u>	<u>90</u>	<u>133</u>
(6) pump <u>1</u> , <u>7</u> (HP) (yield gpm)	<u>comp white sand</u>	<u>133</u>	<u>145</u>
<u>Elet</u> (type power)	<u>lost ret was</u>		
(7) electric log <u>No</u> (yes or no)	<u>still in sand</u>		
(organization running log)			
(8) how well bottom plugged <u>2" blue</u>			
DRILLERS REMARKS: <u>lost ret</u> <u>@ 145 Jelled up</u> <u>Required same</u>			

MISSISSIPPI
 BOARD OF WATER COMMISSIONERS
 MAY 19 1975

MISS. Bd. OF WATER COMM.

If well telescopes please sketch and show depths.

GROUND LEVEL

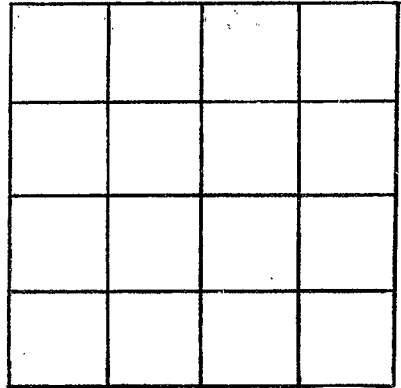

SECTION _____

Please indicate well location X.

ADDITIONAL INFORMATION

If more than one screen, show locations of each on sketch.