


WAYNE  
 U 80  
 7-26-75

MISSISSIPPI  
 BOARD OF WATER COMMISSIONERS CODED  
 416 North State Street  
 Jackson, Mississippi 39201

WATER WELL DRILLERS LOG  
 McILWAIN WATER WELL SERVICE WAYNE  
 RT 2, BOX 35  
 WAYNESBORO, MISS. 39367 county well located

July 26, 1975  
 date well completed

LANDOWNER:	description of formations encountered	from	to
MRS JUDY TAYLOR	Red SANDY Clay	0	15
Rt 1 Bucatonna, Miss. (mailing address)	SAND	15	20
WELL LOCATION: sec. 5 T. 7 N R. 5 E 5 miles N of Bucatonna (distance) (direction) (nearest town)	CLAY, SOME SAND Rocks	20	65
WELL PURPOSE: Home (home, irrigation, municipal, industrial)	SAND + CLAY	65	68
WELL COMPLETION DATA:	Clay	68	85
(1) diameter (inches) 2"	SAND + CLAY STREAKS	85	90
(2) total depth (feet) 113'	CLAY (HEAVING SHALE)	90	100
(3) static water level (feet) 70' below top of ground.	SAND	100	113
(4) casing PVC, 107' (material) (depth) 2" if telescope see back. (size)			
(5) screen 6' 107' (length) (depth to top) 1 1/4" 55 60 GA. (size) (material)			
(6) pump 3/4 4 (HP) (yield gpm) 110 AC (type power)			
(7) electric log NO (yes or no) (organization running log)			
(8) how well bottom plugged			
DRILLERS REMARKS:			

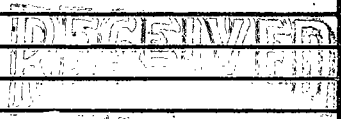


JUL 29 1975

WAYNE CO. MISS. WATER COMM.

If well telescopes please sketch and show depths.

GROUND LEVEL

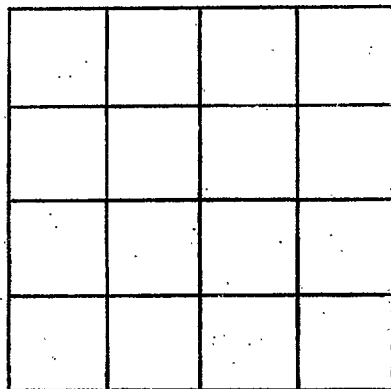

SECTION \_\_\_\_\_

Please indicate well location X.

ADDITIONAL INFORMATION

If more than one screen, show locations of each on sketch.