

Wayne
 U 811
 8-21-75

MISSISSIPPI
 BOARD OF WATER COMMISSIONERS
 416 North State Street
 Jackson, Mississippi 39201

CODED

WATER WELL DRILLERS LOG

AUG 21, 1975 19 date well completed
 RT. 1 BOX 37 WAYNESBORO, MISS. 39367
 McILWAIN WATER WELL SERVICE WAYNE county well located


LANDOWNER:	description of formations encountered	from	to
Jimmy JORDAN	Sand	0	11
Rt 1 Bucatunna, Miss. (mailing address)	White Clay + Pink	11	15
WELL LOCATION: sec. 8 T 7 N R. 5 E 4 miles N of Bucatunna (distance) (direction) (nearest town)	Hard White Clay	15	20
	Med. Sand	20	25
WELL PURPOSE: HOME (home, irrigation, municipal, industrial)	Hard White Clay	25	35
WELL COMPLETION DATA:	Grey Clay	35	45
(1) diameter (inches) 2"	Sand + Clay	45	55
(2) total depth (feet) 68'	Clay	55	58
(3) static water level (feet) 20' below top of ground.	Coarse Sand	58	68
(4) casing PVC 63' (material) (depth) 2" (size) if telescope see back.			
(5) screen 5' 63' (length) (depth to top) 2" PVC .00R (size) (material)			
(6) pump 3/4 12 (HP) (yield gpm) 110 AC (type power)			
(7) electric log NO (yes or no)			
(organization running log)			
(8) how well bottom plugged			

RECEIVED
 SEP 15 1975

DRILLERS REMARKS:

If well telescopes please sketch and show depths.

GROUND LEVEL

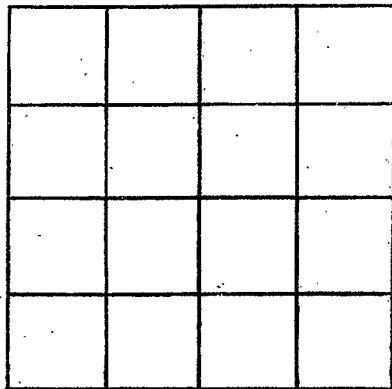

SECTION _____

Please indicate well location X.

ADDITIONAL INFORMATION

If more than one screen, show locations of each on sketch.