

Wayne  
 U 82  
 9-12-75

MISSISSIPPI  
 BOARD OF WATER COMMISSIONERS  
 416 North State Street  
 Jackson, Mississippi 39201

CODED

WATER WELL DRILLERS LOG


SEPT 12, 1975 date well completed  
 McILWAIN WATER WELL SERVICE WAYNE county well located  
 RT. 2 BOX 37 WAYNESBORO, MISS. 39267

LANDOWNER:	description of formations encountered	from	to
EDWARD CHARLES Taylor	Red clay	0	3
Bucatunna, Miss. (mailing address)	Red sand	3	8
WELL LOCATION:	Clay	8	11
sec. 31 T. 7 N R. 5 W	Sand	11	20
1 miles 3 of Bucatunna (distance) (direction) (nearest town)	Coarse sand	20	28
WELL PURPOSE: Home (home, irrigation, municipal, industrial)	Clay	28	41
WELL COMPLETION DATA:	Fine sand	41	43
(1) diameter (inches) 2"	Clay	43	49
(2) total depth (feet) 116'	Med sand	49	51
(3) static water level (feet) 11' below top of ground	Clay	51	54
(4) casing PVC 111' (material) (depth) 2" if telescope see back. (size)	Sand	54	56
(5) screen 5' 111' (length) (depth to top)	Clay	56	106
2" PVC (size) (material)	Fine sand	106	108
(6) pump 3/4 10 (HP) (yield gpm)	Clay	108	110
220 ac (type power)	Med sand	110	116
(7) electric log no (yes or no)			
(organization running log)			
(8) how well bottom plugged			
DRILLERS REMARKS:			

OCT 23  
 MISS. Bd. of W. C.

If well telescopes please sketch and show depths.

GROUND LEVEL

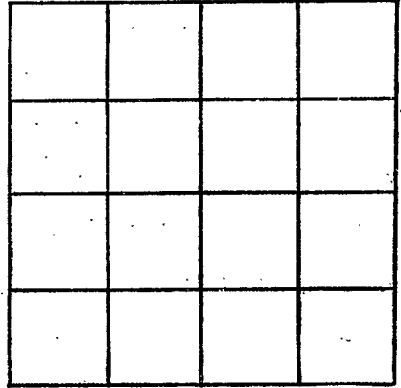

SECTION \_\_\_\_\_

Please indicate well location X.

ADDITIONAL INFORMATION

If more than one screen, show locations of each on sketch.