

WAYNE  
1283  
7-8-78

MISSISSIPPI  
BOARD OF WATER COMMISSIONERS  
416 North State Street  
Jackson, Mississippi 39201

CODE

WATER WELL DRILLERS LOG

McILWAIN WATER WELL SERVICE

July 8

19 78 RT. 2 BOX 32

WAYNE

date/well completed

WAYNESBORO, MISSISSIPPI 39367

county well located

LANDOWNER:	description of formations encountered	from	to
WJ Carr			
Buckatunna Miss (mailing address)	Grey Clay	16	58
WELL LOCATION:	Sand	58	63
sec. 29 T 7 N R 5 @	Clay	63	97
2 miles E of B <sup>W</sup> tunna	Sand	97	215
(distance) (direction) (nearest town)	Blue Clay	215	227
WELL PURPOSE: Farm	Sand & Clay	227	245
(home, irrigation, municipal, industrial)	Blue Clay	245	250
WELL COMPLETION DATA:	Rock & Clay	250	290
(1) diameter (inches) 2"	Sand	290	325
(2) total depth (feet) 325'			
(3) static water level (feet) Flow above top of ground.			
(4) casing PVC 315'			
(material) (depth)			
2" if telescope see back.			
(size)			
(5) screen 10' 315'			
(length) (depth to top)			
2" PVC, 008			
(size) (material)			
(6) pump 20			
(HP) (yield gpm)			
(type power)			
(7) electric log No			
(yes or no)			
(organization running log)			
(8) how well bottom plugged			

CODED


RECEIVED  
AUG 11 1978

DRILLERS REMARKS:

MISS. BD. OF WATER COMMISSIONERS

If well telescopes please sketch and show depths.

GROUND LEVEL

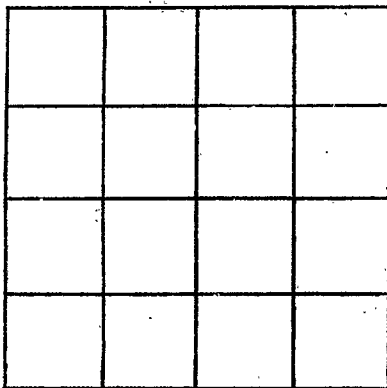

SECTION \_\_\_\_\_

Please indicate well location X.

ADDITIONAL INFORMATION

If more than one screen, show locations of each on sketch.