

MISSISSIPPI DEPARTMENT OF NATURAL RESOURCES

Bureau of Land and Water Resources

Southport Mall

P.O. Box 10631

Jackson, Mississippi 39209

WATER WELL DRILLERS LOG

CODED

WAYNE
u 86

Griner Drilling Service, Inc.

Wayne

8-7-87 date well completed

Griner Drilling Service, Inc. firm name

Wayne county well located

LANDOWNER:	description of formations encountered	from	to
Chesley Pruett Drilling P.O. Box 324 Laurel, MS. 39429 (mailing address)	SAND	0	55
	clay	55	84
WELL LOCATION: 2123' N + 2056' E sec. 18 T. 7 N R. 5 E of No. 1 Birch Buckatunna Borch Sulcor distance (miles) direction (W) of (nearest town)	SAND, PEA GRAVEL	84	168
	clay, SAND, rock	168	250
WELL PURPOSE: oilfield, rig (home, irrigation, municipal, industrial) supply	SAND, PEA GRAVEL	250	285
WELL COMPLETION DATA:			
(1) diameter (inches) 3"			
(2) total depth (feet) 285'			
(3) static water level (feet) 65' below top of ground.			
(4) casing steel, 285' (material) (depth)			
3" if telescope see back. (size)			
(5) screen 42', 243' (length) (depth to top)			
3" perforated (size) (material)			
(6) pump — 80 (HP) (yield gpm)			
AC (type power)			
(7) electric log (yes or no)			
(organization running log)			
(8) how well bottom plugged orange peel			
DRILLERS REMARKS:			

CODED


RECEIVED

SEP 21 1987

Department of Natural Resources
Bureau of Land & Water Resources

If well telescopes please
sketch and show depths.

GROUND LEVEL

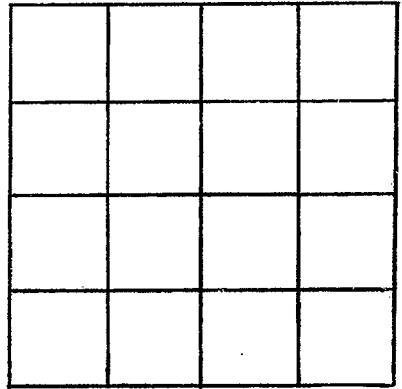

SECTION _____

Please indicate well location X.

ADDITIONAL INFORMATION

If more than one screen,
show locations of each on sketch.