


If well telescopes please sketch and show depths.

GROUND LEVEL

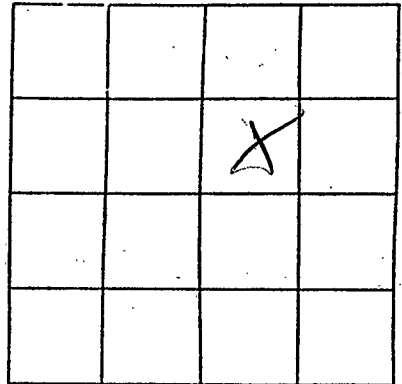

SECTION _____

Please indicate well location X.

| | | | |
|---------------------|---------------|---------------|-----|
| Pump Capacity (GPM) | No. of Stages | Setting Depth | FT. |
|---------------------|---------------|---------------|-----|

PUMP TEST

Well yielded 100 + GPM with
 a drawdown of 5 ft.
 after airlift hours of pumping

LOG DATA

TYPE OF LOG RUN (Circle One): No Log Run, Electric, Gamma Ray, Density, Sonic, Neutron, Other (Describe) _____

Name of Organization Running Log _____

GEOLOGIC DATA (Office Use Only)

| | | | |
|---------------|---------------|----------------|--------------|
| Surface Elev. | Geologic Unit | Unit Thickness | Depth to Top |
| Subs. SWL | Date | Analysis | Aquifer Test |

Driller's Remarks

If more than one screen, show location of each on sketch.