

Wayne
 U 2000
 11/8/75

MISSISSIPPI
 BOARD OF WATER COMMISSIONERS
 416 North State Street
 Jackson, Mississippi 39201

WATER WELL DRILLERS LOG

11-8-75 date well completed
 1975 CARRS well SERV firm name
 DEWYNNE county well located

LANDOWNER: FRANKLIN
 BRADLEY
 RT1 BUCKATUNNA MISS
 (mailing address)

description of formations encountered		from	to
Top soil		0	1
Yellow sand		1	6
Med yellowish sand		6	12
Med white sand		12	20
Coarse white sand		20	35

WELL LOCATION: 13 P
 sec. 14 T-7N R-5E
 4 1/2 miles ENE of BUC
 (distance) (direction) (nearest town)


WELL PURPOSE: HOME
 (home, irrigation, municipal, industrial)

- WELL COMPLETION DATA:
- (1) diameter (inches) 4 3/4 x 2"
 - (2) total depth (feet) 25
 - (3) static water level (feet) 14 ^{below} top of ground.
 - (4) casing PVC, 20 (material) (depth)
 (size) If telescope see back.
 - (5) screen 5' 20 (length) (depth to top)
 2" PVC 8510t (size) (material)
 - (6) pump 1 (HP) 12 (yield gpm)
 Elect (type power)
 - (7) electric log No (yes or no)
- (organization running log)
- (8) how well bottom plugged 2" BWV

DRILLERS REMARKS: Stopped ON TOP OF ROCK

If well telescopes please sketch and show depths.

GROUND LEVEL

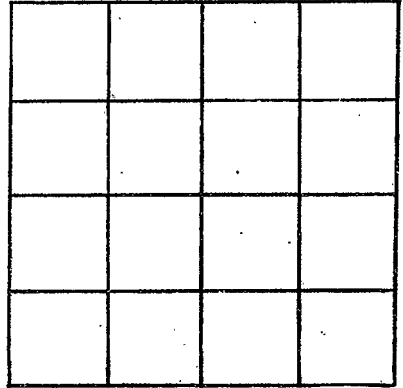

SECTION _____

Please indicate well location X.

ADDITIONAL INFORMATION

If more than one screen, show locations of each on sketch.