

Wayne  
 U  
 11-12-75

MISSISSIPPI  
 BOARD OF WATER COMMISSIONERS  
 416 North State Street  
 Jackson, Mississippi 39201

WATER WELL DRILLERS LOG

DEC - 2 1975

11-12 1975 date well completed  
 CARRS well SERV. firm name  
 Wayne county well located

LANDOWNER: Robert Wood  
 RT1 BUCKINGHAM MISS  
 (mailing address)

description of formations encountered	from	to
Top Soil	0	1
Red SAND	1	8
Yellowish SAND	8	16
Coarse white SAND	16	30

WELL LOCATION:  
 sec. 35 T 7N R 5E 13P  
 S W  
 7 miles EAST of PROGRESS  
 (distance) (direction) (nearest town)

WELL PURPOSE: Home  
 (home, irrigation, municipal, industrial)

- WELL COMPLETION DATA:
- (1) diameter (inches) 4 3/4 X 2
  - (2) total depth (feet) 30
  - (3) static water level (feet) 12 <sup>below</sup>/<sub>above</sub> top of ground.
  - (4) casing PVC 25  
 (material) (depth)  
 (size) if telescope see back.
  - (5) screen 5" 25'  
 (length) (depth to top)  
2" PVC (8 slot)  
 (size) (material)
  - (6) pump 1/2 8  
 (HP) (yield gpm)
  - Elect  
 (type power)
  - (7) electric log No  
 (yes or no)


(organization running log)

(8) how well bottom plugged 2" B.W.U.

DRILLERS REMARKS: Tested @  
12 gal per min  
DRILLED ALLOF SAND

If well telescopes please sketch and show depths.

GROUND LEVEL

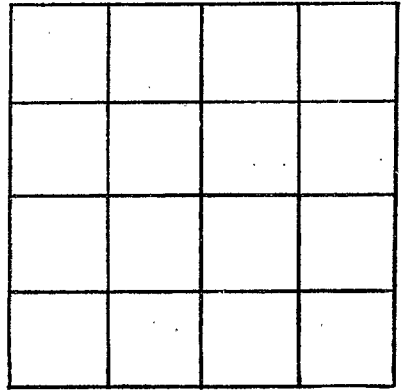

SECTION \_\_\_\_\_

Please indicate well location X.

ADDITIONAL INFORMATION

If more than one screen, show locations of each on sketch.