

Wayne
 U 2000
 11/25/75

MISSISSIPPI
 BOARD OF WATER COMMISSIONERS
 416 North State Street
 Jackson, Mississippi 39201

DEC - 2 1975

WATER WELL DRILLERS LOG

MISS. BOARD OF WATER COMMISSIONERS

11-25 1975 CARP'S Well Services firm name
 Wayne county well located

LANDOWNER: Progress Assn
OF God Church
RT 1 BUCKTOWN MS
 (mailing address)

description of formations encountered	from	to
Top Soil	0	1
yellow sand	1	8
Coarse yellow sand	8	12
white clay	12	14
Fine white clay	14	24
Coarse white sand	24	34

WELL LOCATION:
 sec. 34 T. 7 S. R. 5 E. 13P
1/4 miles North of Progress
 (distance) (direction) (nearest town)


WELL PURPOSE: Home
 (home, irrigation, municipal, industrial)

- WELL COMPLETION DATA:
- (1) diameter (inches) 4 3/4 x 2"
 - (2) total depth (feet) 34
 - (3) static water level (feet) 8 below top of ground.
 - (4) casing PVC 2 3/4'
 (material) (depth)
 (size) if telescope see back.
 - (5) screen 11 23'
 (length) (depth to top)
1/4" PVC 1/8" slot
 (size) (material)
slotted
 - (6) pump 1 10
 (HP) (yield gpm)
elect
 (type power)
 - (7) electric log NO
 (yes or no)
 (organization running log)
 - (8) how well bottom plugged built up point

DRILLERS REMARKS: Cut All
OF SAND
HAVE 12' 3/4" PVC
TAIL PIPE OR JET

If well telescopes please sketch and show depths.

GROUND LEVEL

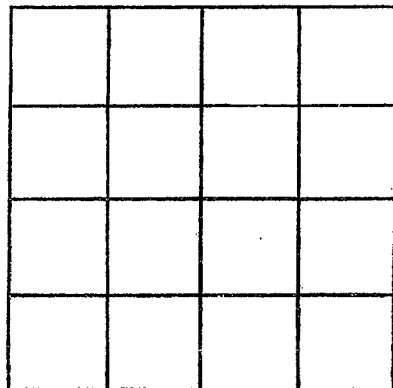

SECTION _____

Please indicate well location X.

ADDITIONAL INFORMATION

If more than one screen,
show locations of each on sketch.