

Wayne  
 71-2003  
 11-29-75

MISSISSIPPI  
 BOARD OF WATER COMMISSIONERS  
 416 North State Street  
 Jackson, Mississippi 39201

WATER WELL DRILLERS LOG

11-29 1975 CARRS well service WAYNE  
 date well completed firm name county well located


LANDOWNER:	description of formations encountered	from	to
<u>Clyde Dobson</u>	<u>Top Soil</u>	<u>0</u>	<u>1</u>
<u>BUCATUNNA MISS</u>	<u>Red Clay</u>	<u>1</u>	<u>8</u>
(mailing address)	<u>Coarse white SAND</u>		
	<u>+ GRAVEL</u>	<u>8</u>	<u>15</u>
WELL LOCATION:	<u>GRAVEL</u>	<u>15</u>	<u>28</u>
sec <u>31</u> T. <u>7N</u> R. <u>5E</u>	<u>Coarse white SAND</u>	<u>28</u>	<u>30</u>
<u>1/4</u> miles <u>South</u> of <u>BU</u>			
(distance) (direction) (nearest town)			
WELL PURPOSE: <u>CHICKEN HOUSE</u>			
(home, irrigation, municipal, industrial)			
WELL COMPLETION DATA:			
(1) diameter (inches) <u>4 3/4 x 2"</u>			
(2) total depth (feet) <u>30</u>			
(3) static water level (feet) <u>9</u> <sup>below</sup> / <sub>above</sub>			
(4) casing <u>PVC</u> <u>26'</u> (material) (depth)			
(size) if telescope see back.			
(5) <u>NSF</u> <u>4'</u> <u>26'</u> screen (length) (depth to top)			
<u>2"</u> <u>PVC (8 slot)</u> (size) (material)			
(6) pump <u>1/2</u> <u>10</u> (HP) (yield gpm)			
<u>Elect</u> (type power)			
(7) electric log <u>NO</u> (yes or no)			
(organization running log)			
(8) how well bottom plugged <u>2" Buil</u>			
DRILLERS REMARKS: <u>Still in</u> <u>SAND when quit</u>			

DEC 17 1975

MISS. BD. OF WATER COMMISSIONERS

If well telescopes please sketch and show depths.

GROUND LEVEL

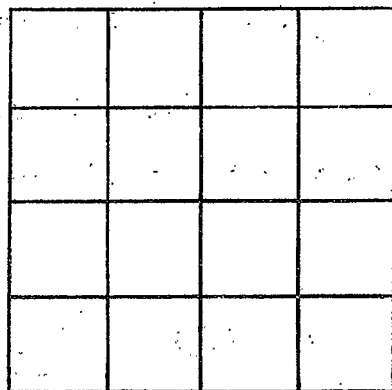

SECTION \_\_\_\_\_

Please indicate well location X.

ADDITIONAL INFORMATION

If more than one screen, show locations of each on sketch.