

Wayne
 2007
 6-7-76

MISSISSIPPI
 BOARD OF WATER COMMISSIONERS
 416 North State Street
 Jackson, Mississippi 39201
 WATER WELL DRILLERS LOG

6-7-76 19 J. R. GREEN - WATER WELL DRILLING WAYNE
 date well completed R.T.E. 6, BOX 77A - PHONE 425-3237 county well located
 LAUREL, MISS. 39440

LANDOWNER: Ronald E. Overstreet
BUCKATUNNA, MS
 (mailing address)
 WELL LOCATION:
 sec. 30 T. 7N R. 4E
W. Buckatunna, MS
 (distance) miles (direction) of (nearest town)

description of formations encountered	from to	
Red Clay Sand	0	10
FINE SAND	10	20
" "	20	30
COARSE SAND	30	40
" "	40	50
white CHALK	50	

WELL PURPOSE:
 (home, irrigation, municipal, industrial)

WELL COMPLETION DATA:
 (1) diameter (inches) 4
 (2) total depth (feet) 50
 (3) static water level (feet) 10 below above top of ground.
 (4) casing PVC 40
 (material) (depth)
 (size) if telescope see back.
 (5) screen 10' 40
 (length) (depth to top)
2x.008 PVC
 (size) (material)
 (6) pump 1 6
 (HP) (yield gpm)
110VAC
 (type power)
 (7) electric log NO
 (yes or no)
 (organization running log)
 (8) how well bottom plugged


DRILLERS REMARKS:
Set pt 35 ft

RECEIVED
 FEB 14 1971

Miss. Bd. of Water Comm.

If well telescopes please sketch and show depths.

GROUND LEVEL

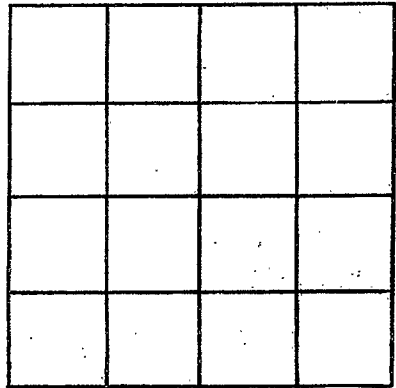

SECTION _____

Please indicate well location X.

ADDITIONAL INFORMATION

If more than one screen, show locations of each on sketch.