

WAYNE
 76 2008
 6-18-76

MISSISSIPPI
 BOARD OF WATER COMMISSIONERS
 416 North State Street
 Jackson, Mississippi 39201


WATER WELL DRILLERS LOG
 McILWAIN WATER WELL SERVICE

June 18, 1976
 date well completed

RT 2 BOX 37
 WAYNESBORO, MISS. 39367


Wayne
 county well located

LANDOWNER:	description of formations encountered	from	to
MR. OTIS JORDAN Waynesboro, Miss. (mailing address)			
WELL LOCATION: sec. 5 T. 7 N R. 5 W 6 miles N of Bucatunna (distance) (direction) (nearest town)	Red Sand	12	29
WELL PURPOSE: Home (home, irrigation, municipal, industrial)	Clay	29	120
WELL COMPLETION DATA: (1) diameter (inches) 2" (2) total depth (feet) 140' (3) static water level (feet) 96' below top of ground. (4) casing PVC 136' (material) (depth) 2" if telescope see back. (size) (5) screen 4' 136' (length) (depth to top) 2" PVC (size) (material) (6) pump 1 5 (HP) (yield gpm) 110 AC (type power) (7) electric log no (yes or no) (organization running log) (8) how well bottom plugged	Fine Sand & Clay	120	131
DRILLERS REMARKS:	Coarse Sand	131	140

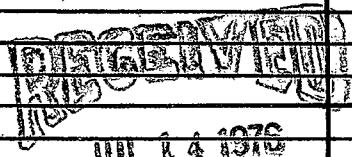

If well telescopes please sketch and show depths.

GROUND LEVEL

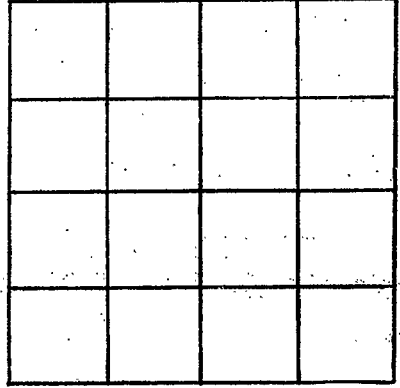

SECTION _____

Please indicate well location X.

ADDITIONAL INFORMATION

If more than one screen, show locations of each on sketch.