

Wayne
 11 300A
 7-8-76

MISSISSIPPI
 BOARD OF WATER COMMISSIONERS
 416 North State Street
 Jackson, Mississippi 39201

WATER WELL DRILLERS LOG

7-8 1976 CARRS Well & Serv WAYNE
 date well completed firm name county well located

LANDOWNER: HARRY CHERRY
 RT1 BOXTONNA MISS
 (mailing address)

WELL LOCATION:
 sec. 4 T-7 N R-5 E
 1/2 miles south of PROGRESS
 (distance) (direction) (nearest town)

WELL PURPOSE: Home
 (home, irrigation, municipal, industrial)

WELL COMPLETION DATA:
 (1) diameter (inches) 2" x 4"
 (2) total depth (feet) 150
 (3) static water level (feet) 56 below top of ground.
 (4) casing PVC 145 (material) (depth)
 (size) If telescope see back.
 (5) screen 5' 145 (length) (depth to top)
 2" PVC (8 slot) (size) (material)
 (6) pump 1 8 (HP) (yield gpm)
 Elect (type power)
 (7) electric log No (yes or no)
 (organization running log)
 (8) how well bottom plugged 2" CAP

description of formations encountered	from	to
TOP SOIL	0	1
yellow CLAY	1	3
yellow, pink & white clay	3	10
pink & white CLAY	10	22
fine fine white SD	22	26
Blue CLAY	26	32
white CLAY	32	65
Blue & pink limonite CLAY	65	75
Blue CLAY	75	110
GRAY CLAY	110	125
COARSE white SAND	125	142
PEA GRAVEL	142	150


DRILLERS REMARKS: Still in PEA GRAVEL when quit DRIG

RECEIVED
 JUL 28 1976

MISS. BD. OF WATER COMMISSIONERS

If well telescopes please
sketch and show depths.

GROUND LEVEL

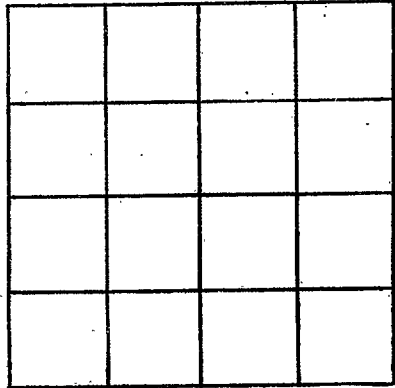

SECTION _____

Please indicate well location X.

ADDITIONAL INFORMATION

If more than one screen,
show locations of each on sketch.