

WAYNE
 U 2010
 7/20/76

MISSISSIPPI
 BOARD OF WATER COMMISSIONERS
 416 North State Street
 Jackson, Mississippi 39201

WATER WELL DRILLERS LOG

7-20 1976 CARRS Well SERV WAYNE
 date well completed firm name county well located

LANDOWNER: Joe Cooper
 Rt BUCATONNA MISS
 (mailing address)

description of formations encountered	from	to
TOP Soil	0	2
Yellow + white CLAY	2	12
Fine white SAND	12	25
CARRS white SAND	25	45

WELL LOCATION:
 sec. 15 T-70_S R-5 E
 4 miles EAST of BUC
 (distance) (direction) (nearest town)


WELL PURPOSE: HOME
 (home, irrigation, municipal, industrial)

- WELL COMPLETION DATA:
- (1) diameter (inches) 2' x 4"
 - (2) total depth (feet) 45
 - (3) static water level (feet) 14 below top of ground.
 - (4) casing PVC 41 (material) (depth)
 - (size) If telescope see back.
 - (5) screen 4' 41 (length) (depth to top)
 - 2" PVC (slots) (size) (material)
 - (6) pump 1 12 (HP) (yield gpm)
 - Elect (type power)
 - (7) electric log NO (yes or no)
 - (organization running log)
 - (8) how well bottom plugged 2" PVC CAP

DRILLERS REMARKS: still in same when quit DRIS

If well telescopes please sketch and show depths.

GROUND LEVEL

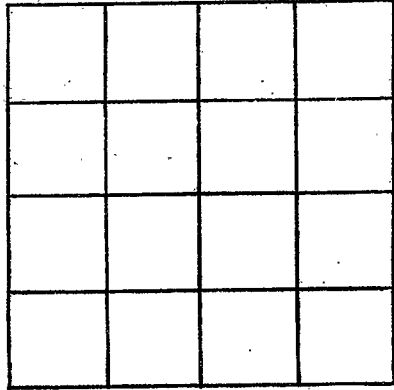

SECTION _____

Please indicate well location X.

ADDITIONAL INFORMATION

If more than one screen, show locations of each on sketch.