

WAYNE  
WELL  
7-21-76

MISSISSIPPI  
 BOARD OF WATER COMMISSIONERS  
 416 North State Street  
 Jackson, Mississippi 39201

WATER WELL DRILLERS LOG

7-21 1976 CARRS Well SERV WAYNE  
 date well completed firm name county well located

LANDOWNER: N.D. DEARMAN  
R1 BUCATONNA

description of formations encountered	from	to
Top Soil	0	1
yellow SAND	1	10
white SAND	10	15
Blue CLAY	15	20
Blue + yellow CLAY	20	23
Blue yellow + pink CLAY	23	27
Blue + pink CLAY	27	30
Blue CLAY	30	57
Fine white SAND	57	65
Coarse white SAND	65	82

(mailing address)

WELL LOCATION:  
 sec. 15 T. 7 N. R. 5 E  
4 1/2 miles EAST of BUC  
 (distance) (direction) (nearest town)

WELL PURPOSE: HOME  
 (home, irrigation, municipal, industrial)


- WELL COMPLETION DATA:
- (1) diameter (inches) 8"
  - (2) total depth (feet) 82'
  - (3) static water level (feet) 10 below above top of ground.
  - (4) casing PVC 77'  
 (material) (depth)
  - (size) If telescope see back.
  - (5) screen 5' 77'  
 (length) (depth to top)
  - 2" PVC (slot)  
 (size) (material)
  - (6) pump 1 10  
 (HP) (yield gpm)
  - Elect  
 (type power)
  - (7) electric log No  
 (yes or no)
  - (organization running log)
  - (8) how well bottom plugged 2" PVC  
CAP

DRILLERS REMARKS: still in SAND when quit  
Tested @ 18 G.P.M.

**RECEIVED**  
 JUL 28 1976

If well telescopes please sketch and show depths.

GROUND LEVEL

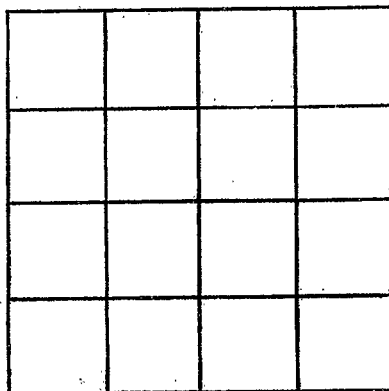

SECTION \_\_\_\_\_

Please indicate well location X.

ADDITIONAL INFORMATION

If more than one screen, show locations of each on sketch.