

Wayne
 11 2053
 9/28/76

MISSISSIPPI
 BOARD OF WATER COMMISSIONERS
 416 North State Street
 Jackson, Mississippi 39201

13P

WATER WELL DRILLERS LOG

9-28 1976 CARRS well service WAYNE
 date well completed firm name county well located

LANDOWNER: EARL CARRIL
 P.O. BUCKATUNNA MISS
 (mailing address)
 WELL LOCATION:
 sec. 4 T. 7 N. R. 5 E
 S W
 5 miles NNE of BUC
 (distance) (direction) (nearest town)

WELL PURPOSE: CHICKEN HOUSE
 (home, irrigation, municipal, industrial)

WELL COMPLETION DATA:
 (1) diameter (inches) 2"
 (2) total depth (feet) 103
 (3) static water level (feet) 50 (below above top of ground)
 (4) casing PVC 98' (material) (depth)
 (size) If telescope see back.
 (5) screen 2" 98' (length) (depth to top)
 2" PVC 8 slot (size) (material)
 (6) pump 1 (HP) (yield gpm)
 Elect (type power)
 (7) electric log No (yes or no)
 (organization running log)
 (8) how well bottom plugged 2" PVC CAP

description of formations encountered	from	to
TOP SOIL	0	1
YELLOW SAND	1	7
BROWN ROCK PINK		
WHITE CLAY	7	11
WHITE CLAY	16	18
BLUE + YELLOW CLAY	18	21
PINK + WHITE CLAY	21	24
YELLOW + WHITE CLAY	24	27
PINK + WHITE CLAY	27	29
YELLOW + WHITE CLAY	29	31
BLUE CLAY	31	35
PINK - YELLOW + WHITE CLAY	35	37
PINK CLAY	37	39
BLUE + PINK CLAY	39	48
BLUE CLAY	48	59
FINE CRYSTALL SD	59	60
BROWN + BLUE CLAY	60	70
YELLOW + PINK CLAY	70	73
FINE WHITE SD	73	78
COARSE WHITE SD	78	103


RECEIVED
 OCT 14 1976

DRILLERS REMARKS: STILL IN SAME WHEEL PART DRILL

MISS. BD. OF WATER COMMISSIONERS

If well telescopes please sketch and show depths.

GROUND LEVEL

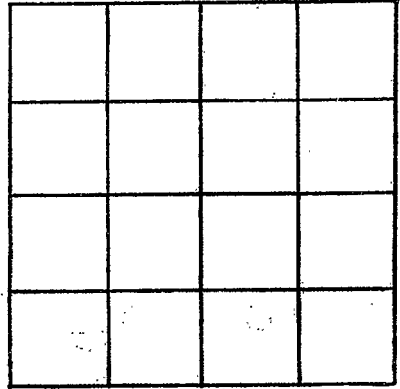

SECTION _____

Please indicate well location X.

ADDITIONAL INFORMATION

If more than one screen, show locations of each on sketch.