

WAYNE
 71 2014
 8/5/76

MISSISSIPPI
 BOARD OF WATER COMMISSIONERS
 416 North State Street
 Jackson, Mississippi 39201
 WATER WELL DRILLERS LOG

8-5 1976 CARRS Well SERV WAYNE
 date well completed firm name county well located

LANDOWNER: OSCAR BRADLEY JR
 RT1 BOCKATONNA MS

description of formations encountered	depth	
	from	to
TOP SOIL	0	1
yellow CLAY	1	12
COARSE white sh	12	18
white CLAY	18	30
COARSE white sh		
Med white sh	30	55
COARSE yellowish sh	55	67

(mailing address)
 WELL LOCATION:
 sec. 14 T. 4 N. R. 5 E
 1/2 miles ENE of BUC
 (distance) (direction) (nearest town)

WELL PURPOSE: CHICKEN HOUSE
 (home, irrigation, municipal, industrial)


WELL COMPLETION DATA:
 (1) diameter (inches) 2"
 (2) total depth (feet) 67
 (3) static water level (feet) 35' below top of ground.
 (4) casing PVC 62 (material) (depth)
 (size) if telescope see back.
 (5) screen 5' 62 (length) (depth to top)
 2" PVC 8 slot (size) (material)
 (6) pump 1 10 (HP) (yield gpm)
 Elect (type power)
 (7) electric log No (yes or no)
 (organization running log)
 (8) how well bottom plugged 2" PVC CAP

DRILLERS REMARKS:

RECEIVED
 SEP 22 1976
 MISS. BD. OF WATER COMM.

If well telescopes please sketch and show depths.

GROUND LEVEL

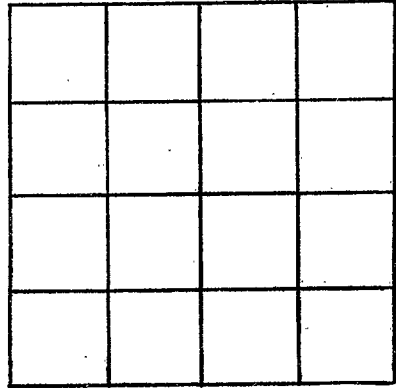

SECTION _____

Please indicate well location X.

ADDITIONAL INFORMATION

If more than one screen, show locations of each on sketch.