

WAYNE  
 U 2015  
 9/9/76

MISSISSIPPI  
 BOARD OF WATER COMMISSIONERS  
 416 North State Street  
 Jackson, Mississippi 39201

WATER WELL DRILLERS LOG

9-9 1976 CARRS Well Serv U WAYNE  
 date well completed firm name county well located

LANDOWNER: JIM HOPKINS  
R+I BUCKATUNNA MS

(mailing address)

WELL LOCATION:  
 sec 30 T. 70 N R. 5 E  
3/4 miles ENE of BUC  
 (distance) (direction) (nearest town)

WELL PURPOSE: Home  
 (home, irrigation, municipal, industrial)

WELL COMPLETION DATA:

- (1) diameter (inches) 2"
- (2) total depth (feet) 31
- (3) static water level (feet) 18 below above top of ground.
- (4) casing PVC 26'  
 (material) (depth)  
 (size) if telescope see back.
- (5) screen 5' 26'  
 (length) (depth to top)  
2" PVC (8 slot)  
 (size) (material)
- (6) pump 1/2 8  
 (HP) (yield gpm)  
Elect  
 (type power)
- (7) electric log No  
 (yes or no)  
 (organization running log)
- (8) how well bottom plugged 2" PVC  
CAP


DRILLERS REMARKS: Still in  
PER GRAVEL  
where bit lost  
Ret @ 25'

description of formations encountered	from to	
Top soil	0	1
GR Clay	1	5
Pink+white Clay	5	10
GR+white Clay	10	14
White Clay	14	16
Med white SD	16	25
PER GRAVEL	25	31

RECEIVED  
 SEP 22 1976  
 MISS. BD OF WATER CONTROL

If well telescopes please sketch and show depths.

GROUND LEVEL

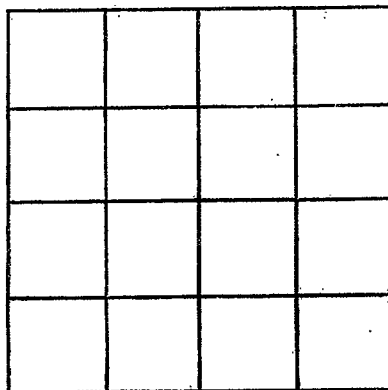

SECTION \_\_\_\_\_

Please indicate well location X.

ADDITIONAL INFORMATION

If more than one screen, show locations of each on sketch.