

WAYNE
 11/1/76

MISSISSIPPI
 BOARD OF WATER COMMISSIONERS
 416 North State Street
 Jackson, Mississippi 39201

WATER WELL DRILLERS LOG

13P
 date well completed: Nov 1 1976 firm name: Porter Drilling Inc county well located: Wayne

LANDOWNER: Joe Thorne
Coolley
211 Buckatunna
 (mailing address)
 WELL LOCATION:
 sec 21 T 7 N 5 E
2 miles E of Buckatunna
 (distance) (direction) (nearest town)

description of formations encountered	from	to
sand	0	15
clay	15	52
sand	52	186
clay	186	211
sand some clay	211	220
small coarse blue clay	220	243
clay	243	252
sand & gravel	252	269
clay	269	279
sand & clay	279	297
thin sand & clay		297
sand & clay	297	315
thin sand some sand	315	341
at foot on clay		

WELL PURPOSE: dom
 (home, irrigation, municipal, industrial)

WELL COMPLETION DATA:
 (1) diameter (inches) 2"
 (2) total depth (feet) 341
 (3) static water level (feet) 120 below top of ground.
 (4) casing PVC (material) 333 (depth)
2" (size) if telescope see back.
 (5) screen 2" (length) 333 (depth to top)
2" (size) 7 slot SS (material)
 (6) pump 3/4 (HP) 12 (yield gpm)
clay (type power)
 (7) electric log no (yes or no)
 (organization running log)
 (8) how well bottom plugged 1 1/2" block was broken


DRILLERS REMARKS:

RECEIVED
 DEC 6 1976

MISS. BD. OF WATER COMMISSIONERS

If well telescopes please sketch and show depths.

GROUND LEVEL

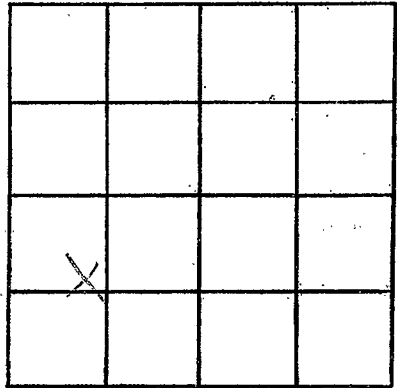

SECTION 21

Please indicate well location X.

ADDITIONAL INFORMATION

If more than one screen, show locations of each on sketch.