

WAYNE  
 U 208  
 8/28/77

MISSISSIPPI  
 BOARD OF WATER COMMISSIONERS  
 416 North State Street  
 Jackson, Mississippi 39201  
 WATER WELL DRILLERS LOG

8-28 1977 CARRS well SERV WAYNE  
 date well completed firm name county well located

LANDOWNER: ALTON  
 KIRKWOOD  
 RAI BUCKATUNNA MISS  
 (mailing address)  
 WELL LOCATION:  
 sec. 14 T 7 N R 5 E  
 S E  
 4 1/4 miles EAST of BUC  
 (distance) (direction) (nearest town)

WELL PURPOSE: HOME  
 (home, irrigation, municipal, industrial)

WELL COMPLETION DATA:  
 (1) diameter (inches) 2"  
 (2) total depth (feet) 95  
 (3) static water level (feet) 47 below above top of ground.  
 (4) casing PVC 90 (material) (depth) (size) if telescope see back.  
 (5) screen 5' 90 (length) (depth to top) 2" PVC 8 slot (size) (material)  
 (6) pump 1 7 (HP) (yield gpm) Elect (type power)  
 (7) electric log No (yes or no)  
 (organization running log)  
 (8) how well bottom plugged 2" PVC CAP

description of formations encountered	from	to
yellow SD	0	7
med white SD	7	12
COARSE white SD	12	15
white CLAY	15	27
white + PINK CLAY	27	35
white CLAY	35	38
white + PINK CLAY	38	40
Med Red SD	40	48
BROWN ROCK	48	50
COARSE B/R SD	50	60
WHITE CLAY	60	65
MED. WHITE SD	65	80
COARSE YEL. SD	80	85
WHITE CLAY	85	86
COARSE WHITE SD	86	95


RECEIVED  
 SEP 19 1977

DRILLERS REMARKS:

MISSISSIPPI WATER COMPANY

If well telescopes please sketch and show depths.

GROUND LEVEL

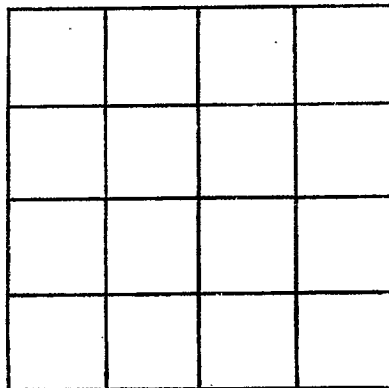

SECTION \_\_\_\_\_

Please indicate well location X.

ADDITIONAL INFORMATION

If more than one screen, show locations of each on sketch.