

WAYNE
U 2221
10-18-77

MISSISSIPPI
BOARD OF WATER COMMISSIONERS
416 North State Street
Jackson, Mississippi 39201

13P

WATER WELL DRILLERS LOG

WILWAY WATER WELL SERVICE

Oct 18
date well completed

19 77 RT 2 BOX 37

Wayne
county well located

WAYNESBORO, MISS 39367

LANDOWNER:
Franklin Jordan
Waynesboro, Miss
(mailing address)

description of formations encountered

WELL LOCATION:
sec. 8 T. 7 N R. 5 E
S W
3 1/2 miles NE of Ruckafarra
(distance) (direction) (nearest town)

Red SAND from 0 to 8

WELL PURPOSE: Home
(home, irrigation, municipal, industrial)

CLAY from 8 to 13

WELL COMPLETION DATA:
(1) diameter (inches) 2"

SAND & CLAY from 13 to 20

(2) total depth (feet) 103'

SAND from 20 to 37

(3) static water level (feet) 100' below above top of ground.

CLAY from 37 to 80

(4) casing PVC 98'
(material) (depth)

FINE SAND & CLAY from 80 to 85

2"
(size) if telescope see back.

(5) screen 5' 98'
(length) (depth to top)

2" PVC
(size) (material)

(6) pump 3/4 4
(HP) (yield gpm)

110 AC
(type power)

(7) electric log NA
(yes or no)

(organization running log)

(8) how well bottom plugged

DRILLERS REMARKS:


RECEIVED

NOV 11 1977

MISS. BD. OF WATER COMM

If well telescopes please sketch and show depths.

GROUND LEVEL

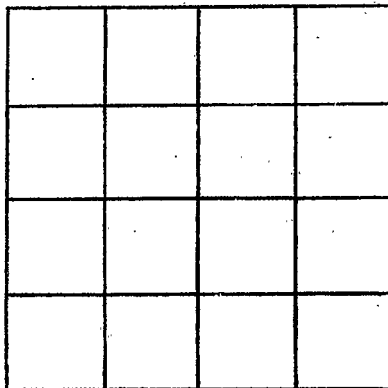

SECTION _____

Please indicate well location X.

ADDITIONAL INFORMATION

If more than one screen, show locations of each on sketch.