

WAYNE

U 20013

6/2/78

MISSISSIPPI BOARD OF WATER COMMISSIONERS  
416 North State Street  
Jackson, Mississippi 39201

WATER WELL DRILLERS LOG

June 2 1978 *Porter Drilling & Pipe* *Wayne*  
date well completed firm name county well located

LANDOWNER: *Leroy Singley*

description of formations encountered

from to

*At 1 Buckatanna, Miss*  
(mailing address)

WELL LOCATION:

sec. 4 T. 10 N. R. 5  
5 miles N of Buckatanna  
(distance) (direction) (nearest town)

WELL PURPOSE: *log marker*  
(home, irrigation, municipal, industrial)

WELL COMPLETION DATA:

- (1) diameter (inches) 2"
- (2) total depth (feet) 100'
- (3) static water level (feet) 42' below top of ground.
- (4) casing P.V.C, 95'  
(material) (depth)  
2" If telescope see back.  
(size)
- (5) screen 5' 95'  
(length) (depth to top)  
1/4" galv S.S.  
(size) (material)
- (6) pump 1 11  
(HP) (yield gpm)  
elec.  
(type power)
- (7) electric log no  
(yes or no)
- (organization running log)
- (8) how well bottom plugged 1/4" back wash valve

Clay	0	8
red sand	8	21
Clay	21	34
sand & clay	34	86
Clay	86	87
sand	87	100
slight white shell in sand		
shell trap above screen		
62' 1" P.V.C. drive pipe		

RECEIVED


JUN 19 1978

DRILLERS REMARKS:

MISS. BB. OF WATER COMM.

and show depths.

GROUND LEVEL

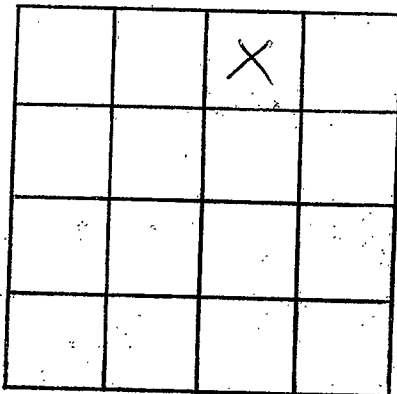

SECTION 4

Please indicate well location X.

ADDITIONAL INFORMATION

If more than one screen,  
show locations of each on sketch.