

WAYNE

66-2005

8-2-78

MISSISSIPPI BOARD OF WATER COMMISSIONERS 416 North State Street Jackson, Mississippi 39201

WATER WELL DRILLERS LOG

Aug. 2

date well completed

WAYNE WATER WELL SERVICE

RT. 2 firm name

37 39267

WAYNE

county well located

LANDOWNER:

Red Creek Church of God WAYNESBORO, MS. (mailing address)

description of formations encountered

from

to

Red Clay

0

3

Clay

3

7

SAND

7

12

Clay

12

70

WELL LOCATION:

sec. 4 T 7 N R 5 E 10 miles SE of W'boro (distance) (direction) (nearest town)

WELL PURPOSE: CHURCH (home, irrigation, municipal, industrial)

WELL COMPLETION DATA:

- (1) diameter (inches) 2"
(2) total depth (feet) 169'
(3) static water level (feet) 95' below top of ground.
(4) casing PVC 164' (material) (depth)
2" (size) if telescope see back.
(5) screen 5' 164' (length) (depth to top)
2" PVC .008 (size) (material)
(6) pump 1/2 4 (HP) (yield gpm)
220 AC (type power)
(7) electric log NO (yes or no)

FINE SAND

70

75

Clay

75

115

Fine Sand

115

117

Heaving Shale

117

150

SAND


150

169

(organization running log)

(8) how well bottom plugged


DRILLERS REMARKS:

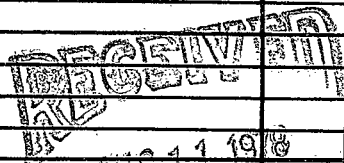

MISS. BD. OF WATER COMMISSIONERS

If well telescopes please sketch and show depths.

GROUND LEVEL

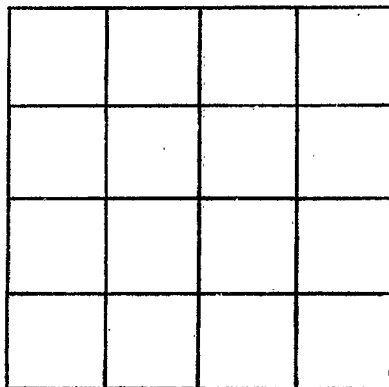

SECTION _____

Please indicate well location X.

ADDITIONAL INFORMATION

If more than one screen,
show locations of each on sketch.